

KANSAS

Form 51-5M-7-39-Palace

Ellsworth

Section 8 Township 16 Range 10-W

Well No. #2 Svoboda


Company Gulf

Stoltenberg Pool

NORTH

WEST

EAST

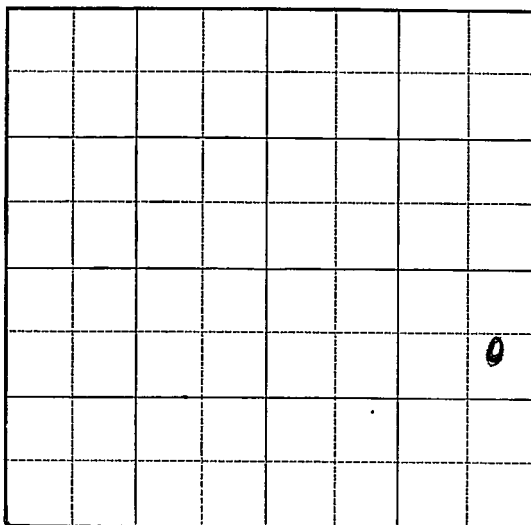

SOUTH

KANSAS

Ellsworth

Sec. 8 Twp. 16 R. 10-WWell No. #2 Svoboda Farm 1

Gulf

Company

(Stoltenberg)

720

Ft. from N. Line


Ft. from S. Line

330

Ft. from E. Line

Ft. from W. Line

Elev. 1844

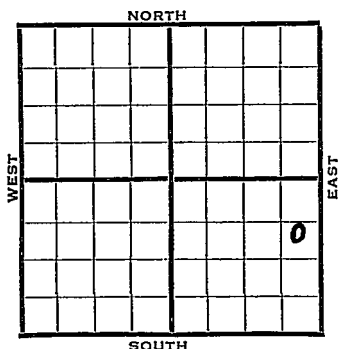

1940	REPORT
3/27	Rotary.
4/4	8" - 390' Drlg. 1735'
4/12	Drlg. 3279'
4/18	Arb. 3301½' 5" - 3302'
	T.D. 3313' 2900' oil 20 hours.
4/25	2000 acid. Pump 65 bbls. 4
	hours. TD 3323' SD.
5/1	Arb. 3301½'
	5" - 3302'
	T.D. 3323'
	4000 acid.
	Depthograph potential 12,737 bbls.
	Maximum 3000 bbls.
	COMPLETED

Map No. 55 Sec. 8 Twp. 16 R. 10WWell No. 2 SvobodaGulf

Company

Contractor

FIRST REPORT**C E L N E S E**720 Ft. from N. Line Ft. from S. Line330 Ft. from E. Line Ft. from W. Line**SECTION PLAT**

			2

STOLTENBERG POOLLocation Rig up

Drilling and Remarks:

Rotary**RECORD**Cased in., ft.Sand Gas Oil Total Depth **PRODUCTION**1st 24 hrs. Nat. 1st 24 hrs. after shot Gas Cu. Ft.Dry Hole Abandoned

Date

MAR 27 1940

19

S. J. LEWIS

Scout

Map No. 55 Sec. 8 Twp. 16 R. 10WWell No. 2 Svoboda

Gulf

Company

Contractor

COMPLETED

SECTION PLAT

C E L N E S E

720 Ft. from N. Line

Ft. from S. Line

330 Ft. from E. Line

Ft. from W. Line

STOLTENBERG POOL

Location _____

Rig up _____

Drilling and Remarks:

*Cr & 3301 1/2**5" @ 3302**4000 acid**Depth graph P & X**12 787**Maximum 3000*

RECORD

Cased _____ in., _____ ft.

Sand _____

Gas _____

Oil _____

Total Depth 3823

PRODUCTION

1st 24 hrs. Nat. _____

1st 24 hrs. after shot _____

Gas _____ Cu. Ft.

Dry Hole _____

Abandoned _____

Date

MAY 1 1940 19

S. J. EWIS Scout