

KANSAS

Form 51-5M-7-40-Palace


Ellsworth

Section 8 Township 16 Range 10-W

Well No. #3 Svoboda

Company Gulf

NORTH Stoltenberg Pool

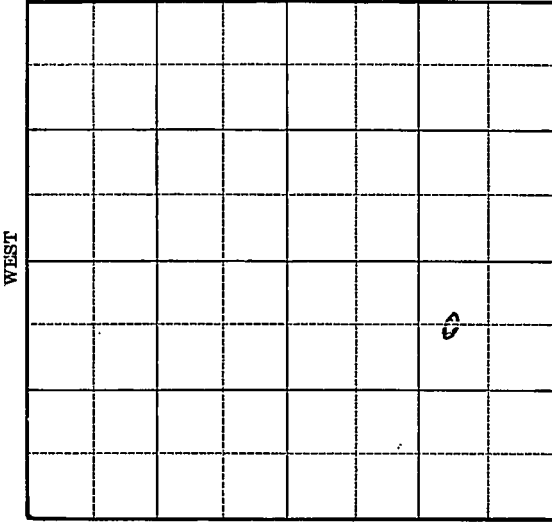

9

6

Map No. 55 Sec. 8 Twp. 16 R. 10W

Well No. 3 Svoboda

Gulf

Company

Contractor

FIRST REPORT

C W L N E S E

666 Ft. from N. Line

_____ Ft. from S. Line

990 Ft. from E. Line

_____ Ft. from W. Line

STOLTENBERG POOL

SECTION PLAT

			0

Location _____

Rig up _____

Drilling and Remarks:

Derrick

RECORD

Cased _____ in., _____ ft.

Sand _____

Gas _____

Oil _____

Total Depth _____

PRODUCTION

1st 24 hrs. Nat. _____

1st 24 hrs. after shot _____

Gas _____ Cu. Ft.

Dry Hole _____

Abandoned _____

Date

AUG 7 1940₁₉

S. J. LEWIS Scout

Map No. 55 Sec. 8 Twp. 16 R. 10W

Well No. 3 Svoboda

Gulf Company

Contractor

COMPLETE
C W L N E S E

SECTION PLAT

666 Ft. from N. Line

_____ Ft. from S. Line

990 Ft. from E. Line

_____ Ft. from W. Line

			0

STOLTENBERG POOL

Location _____

Rig up _____

Drilling and Remarks:

Cr 8 3317
5" C 3317
2000 acid
Pump. 143 oil
420 Water P.O.

RECORD

Cased _____ in., _____ ft.

Sand _____

Gas _____

Oil _____

Total Depth 3337

PRODUCTION

1st 24 hrs. Nat. _____

1st 24 hrs. after shot _____

Gas _____ Cu. Ft.

Dry Hole _____

Abandoned _____

Date

SEP 25 1940 19_____

S. J. LEWIS Scout