

KANSAS

Ellsworth


FORM 51 5M 10-41 PETROL

Section 8 Township 16 Range 10-W

Well No. #4 Kralik

Company Cities Service Oil

Stol Tenberg Pool

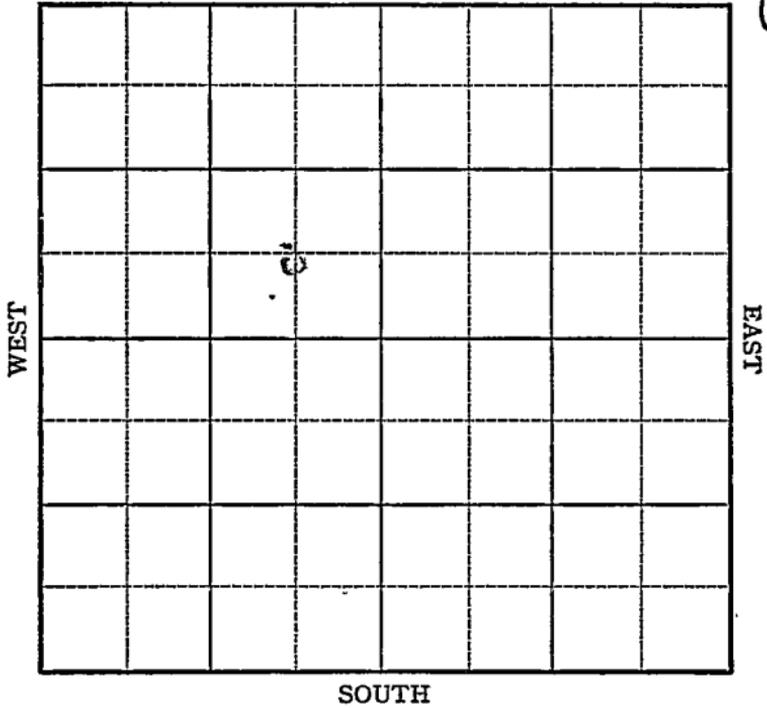


Sec. 8 Twp. 16 R. 10-W

Well No. #4 Kralik Farm

Cities Service Oil Company

(Stoltenberg Pool)

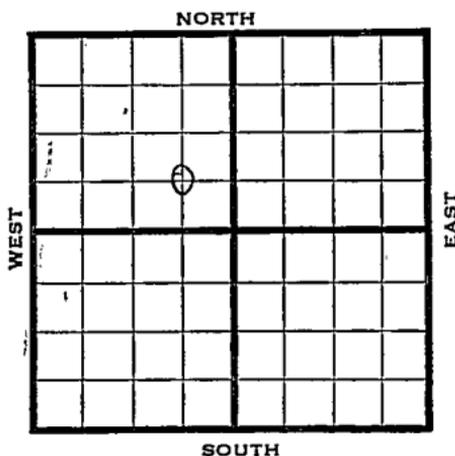

_____ Ft. from N. Line

660 Ft. from S. Line

660 Ft. from E. Line

_____ Ft. from W. Line

Elev. 1844

REPORT

1942

9/9

Location

9/16

10" @ 333 WOC

9/23

Drlg 2572

9/30

TD 3313 7" - 3312 WOC.

Arb. 3301'

10/7

" "

10/14

TD 3322'

1500 acid Pump 81 oil in 8 hrs.

10/21

Arb. 3301 7" @ 3312

T.D. 3322

1500 acid

Depth. ~~to~~ Pot. 3319

Max. 3000

44.2 Gravity

COMPLETED

KANSAS

Ellsworth

Map No. 55 Sec. 8 Twp. 16 R. 10W

Well No. 4 Kralik

Cities Service Oil Company

FIRST REPORT

Contractor

C SE NW

SECTION PLAT

_____ Ft. from N. Line

660 Ft. from S. Line

660 Ft. from E. Line

_____ Ft. from W. Line

	o		

STOLTENBERG POOL

Location XXX

Rig up _____

Drilling and Remarks: _____

RECORD

Cased _____ in., _____ ft.

Sand _____

Gas _____

Oil _____

Total Depth _____

PRODUCTION

1st 24 hrs. Nat. _____

1st 24 hrs. after shot _____

Gas _____ Cu. Ft.

Dry Hole _____

Abandoned _____

Date

SEP 9 1942 19

S. J. LEWIS Scout

Ellsworth

KANSAS
10WMap No. 55 Sec. 8 Twp. 16 R. 10WWell No. 4 KralikCities Service Oil CompanyCOMPLETED Contractor

C SE NW

SECTION PLAT

	o		

_____ Ft. from N. Line

660 Ft. from S. Line660 Ft. from E. Line

_____ Ft. from W. Line

'STOLTENBERG POOL

Location _____

Rig up _____

Drilling and Remarks:

Per Y 3301
7" @ 3312
1500 acid
Sept & Oct 3319
Max 3000
44 2 Gw

RECORD

Cased _____ in., _____ ft.

Sand _____

Gas _____

Oil _____

Total Depth' 3322

PRODUCTION

1st 24 hrs. Nat. _____

1st 24 hrs. after shot _____

Gas _____ Cu. Ft.

Dry-Hole _____

Abandoned _____

Date

OCT 21 1942 19S. J. LEWIS Scout