

KANSAS

Ellsworth


FORM 51 5M 4-41 PETROL

Section 8 Township 16 Range 10-W

Well No. #4 Svoboda

Company Gulf

NORTH Stoltenberg Pool

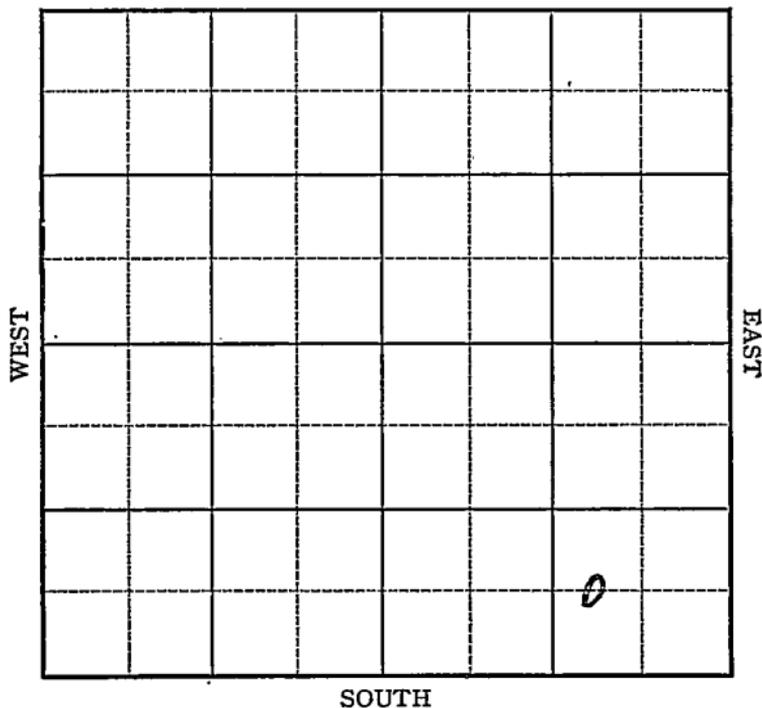

Map No. 17-55 Sec. 8 Twp. 16 R. 10WWell No. 4 SvobodaGulf

Company

Contractor

FIRST REPORT

C WL SE SE

SECTION PLAT

			b

 Ft. from N. Line660 Ft. from S. Line990 Ft. from E. Line Ft. from W. Line**STOLTENBERG POOL**Location Rig up

Drilling and Remarks:

Drilling 320'**RECORD**Cased in., ft.Sand Gas Oil Total Depth **PRODUCTION**1st 24 hrs. Nat. 1st 24 hrs. after shot Gas Cu. Ft.Dry Hole Abandoned

Date

OCT 1 1941 19S. J. LEWIS Scout

Map No. 17-55 Sec. 8 Twp. 16 R. 10W

Well No. 4 Svoboda

Gulf Company

COMPLETED Contractor

C WL SE SE

SECTION PLAT

_____ Ft. from N. Line

660 Ft. from S. Line

990 Ft. from E. Line

_____ Ft. from W. Line

			6

STOLTENBERG POOL

Location _____

Rig up _____

Drilling and Remarks:

Core 3364 1/2
6" @ 3365 1/2
2000 rods
Pump 295 P.S.

44 e/gw

RECORD

Cased _____ in., _____ ft.

Sand _____

Gas _____

Oil _____

Total Depth 3376 1/2

PRODUCTION

1st 24 hrs. Nat. _____

1st 24 hrs. after shot _____

Gas _____ Cu. Ft.

Dry Hole _____

Abandoned _____

Date

OCT 29 1941 19

S. J. LEWIS Scout