

KANSAS

Form 51-5M-7-40-Palace


Ellsworth

Section 8 Township 16 Range 10-W

Well No. #4 Talsky

Company Beardmore Drilling

NORTH Stoltenberg Pool

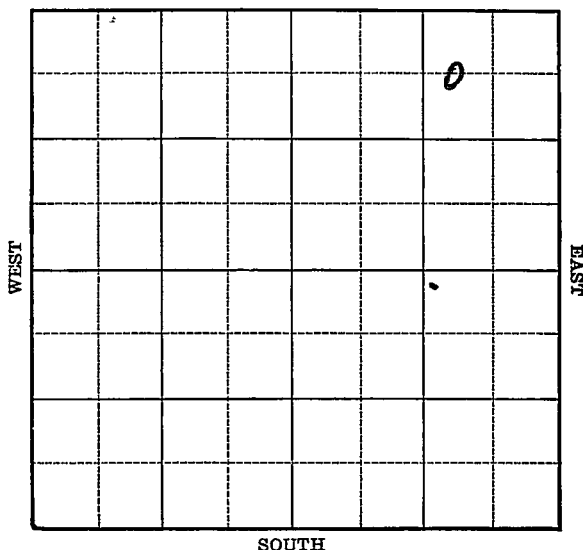

KANSAS

Ellsworth


Sec. 8 Twp. 16 R. 10-WWell No. #4 Talsky FarmBeardmore Drilling

Company

(Stoltenberg)

660 Ft. from N. Line Ft. from S. Line990 Ft. from E. Line Ft. from W. Line

Elev. 1800

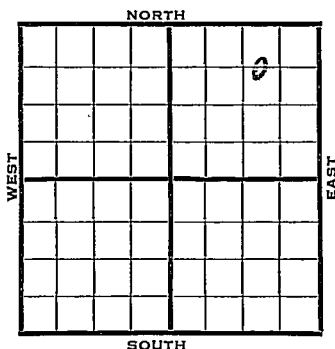

SOUTH

REPORT

1940

8/14 Cellar.

8/22 R.U.R.

8/29 "

9/5 "

9/12 Surface hole.

9/19 8" - 294'

Drlg. 2780'

9/26 Arb. 3255' 5" - 3258'

Drlg. 3270' 3100' oil 2 hours.

10/2 Arb. 3255'

5" - 3258'

T.D. 3273'

Echometer potential 100,241 bbls.

Maximum 3000 bbls.

COMPLETED

Map No. _____ Sec. 8 Twp. 16 R. 10WWell No. 4 TalskyBeardmore Drilling Company

Contractor

SECTION PLAT

660 C W L NE NE

Ft. from N. Line

Ft. from S. Line

990 Ft. from E. Line

Ft. from W. Line

STOLTENBERG POOL

			0

Location _____

Rig up _____

Drilling and Remarks:
cellar

RECORD

Cased _____ in., _____ ft.

Sand _____

Gas _____

Oil _____

Total Depth _____

PRODUCTION

1st 24 hrs. Nat. _____

1st 24 hrs. after shot _____

Gas _____ Cu. Ft.

Dry Hole _____

Abandoned _____

Date

AUG 14 1940 19 _____ S. J. LEWIS Scout

Map No. 55 Sec. 8 Twp. 16 R. 10WWell No. 4 TalskyBeardmore Drilling CompanyContractor**COMPLETE****C W L NE NE**660 Ft. from N. Line Ft. from S. Line990 Ft. from E. Line Ft. from W. Line**STOLTENBERG POOL****SECTION PLAT**

			0

Location Rig up

Drilling and Remarks:

*Cor 3255**5" C 3258**Ech R 100241**Mag 3000***RECORD**Cased in., ft..Sand Gas Oil Total Depth 3273**PRODUCTION**1st 24 hrs. Nat. 1st 24 hrs. after shot Gas Cu. Ft.Dry Hole Abandoned

Date

OCT 2 1940 19 S. J. LEWIS Scout