

KANSAS

FORM 51 5M 10-41 PETROL


Ellsworth

Section 8 Township 16 Range 10-W

Well No. #5 Svoboda

Company Gulf

Stoltenberg Pool NORTH

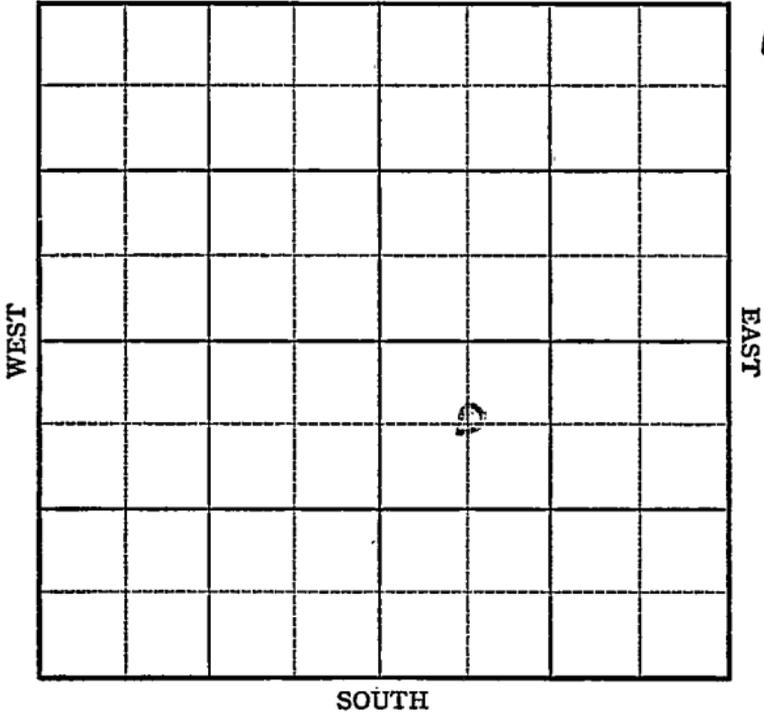

Sec. 8 Twp. 16 R. 10-W

Well No. #5 Svoboda Farm

Gulf

Company

(Stoltenberg Pool)


660 Ft. from N. Line

_____ Ft. from S. Line

_____ Ft. from E. Line

660 Ft. from W. Line

Elev. 1839

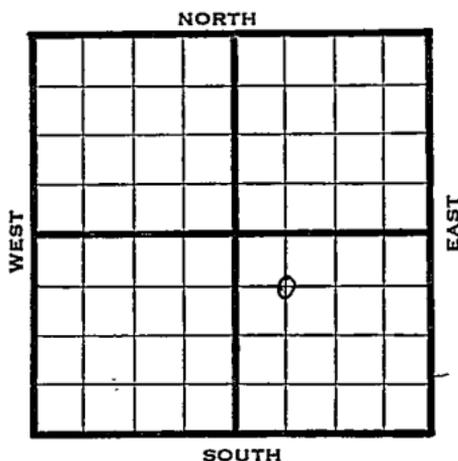

1942

REPORT

9/9 Location

9/16 8" @ 310 Drlg 740

9/23 Drlg 3135

9/30 TD 3320 filled 1100' oil
5 1/2 hours - no water - tstg
5 1/2" - 3310

10/7 TD 3324 1900' oil in 9 1/2 hrs
3000 acid

10/14 Arb. 3308
5" - 3310
3000 acid
Pump 179 oil plus 333 water Pot.
Gravity 43.6
T.D. 3324'

COMPLETED

Map No. 55 Sec. 8 Twp. 16 R. 10W

Well No. 5 Svoboda

Gulf Company

FIRST REPORT Contractor

C NW SE

SECTION PLAT

660 Ft. from N. Line

_____ Ft. from S. Line

_____ Ft. from E. Line

660 Ft. from W. Line

		o	

STOLTENBERG POOL

Location XXX

Rig up _____

Drilling and Remarks:

RECORD

Cased _____ in., _____ ft.

Sand _____

Gas _____

Oil _____

Total Depth _____

PRODUCTION

1st 24 hrs. Nat. _____

1st 24 hrs. after shot _____

Gas _____ Cu. Ft.

Dry Hole _____

Abandoned _____

Date

SEP 9 1942 19

S. J. LEWIS Scout

Ellsworth

Map No. 55 Sec. 8 Twp. 16 R. 10WWell No. 5 SvobodaGulf

Company

COMPLETED

Contractor

C NW SE

SECTION PLAT

660 Ft. from N. Line

_____ Ft. from S. Line

_____ Ft. from E. Line

660 Ft. from W. Line

		2	

STOLTENBERG POOL

Location _____

Rig up _____

Drilling and Remarks:

*Cr 8 3308**5" @ 3310**3000 aadl**Pump 179 oil
+ 333 Water Prod**436 Gr*

RECORD

Cased _____ in., _____ ft.

Sand _____

Gas _____

Oil _____

Total Depth 3324

PRODUCTION

1st 24 hrs. Nat. _____

1st 24 hrs. after shot _____

Gas _____ Cu. Ft.

Dry Hole _____

Abandoned _____

Date

OCT 14 1942 19S. J. LEWIS Scout