


KANSAS

FORM 51 5M 4-41 PETROL Ellsworth

Section 8 Township 16 Range 10-W

Well No. 3 Kralik

Company Cities Service Oil

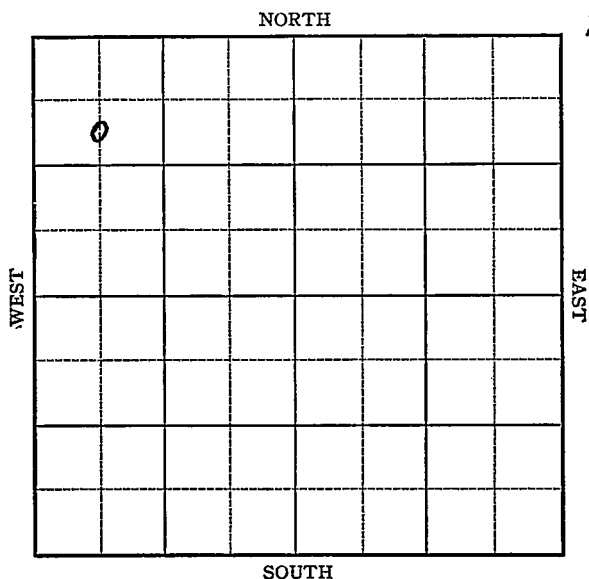

Sec. 8 Twp. 16 R. 10-W

Well No. #3 Kralik Farm

Cities Service Oil Company

(Stoltenberg)


990 Ft. from N. Line

_____ Ft. from S. Line

_____ Ft. from E. Line

660 Ft. from W. Line

Elev. 1832

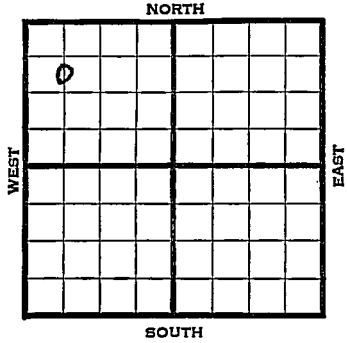

1941	REPORT
7/9	8" - 396' WOC.
7/17	Drlg. 2875'
7/24	Arb 295 5" @ 3307-10 TD RUST
7/30	Arb 3295'
	TD 3319'
	5" @ 3307'
	2000 acid
	Depth Pot. 5428'
	Maximum 3000
	44 Gravity.
	COMPLETED

Map No. _____ Sec. 8 Twp. 16 R. 10W

Well No. 3 Kralik

Cities Service Oil Company

Contractor _____

FIRST REPORT

SECTION PLAT

C S L NW NW

990 Ft. from N. Line

_____ Ft. from S. Line

_____ Ft. from E. Line

660 Ft. from W. Line

o			

STOLTENBERG POOL

Location _____

Rig up _____

Drilling and Remarks:

8" - 396 WOC

RECORD

Cased _____ in., _____ ft.

Sand _____

Gas _____

Oil _____

Total Depth _____

PRODUCTION

1st 24 hrs. Nat. _____

1st 24 hrs. after shot _____

Gas _____ Cu. Ft.

Dry Hole _____

Abandoned _____

Date

JUL 9 1944 19

S. J. LEWIS Scout

Map No. _____ Sec. **8** Twp. **16** R. **10W** **KANSAS**

Well No. **3 Kralik**

Cities Service Oil Company

COMPLETED Contractor

SECTION PLAT

o			

C S L NW NW

990 Ft. from N. Line

_____ Ft. from S. Line

_____ Ft. from E. Line

660 Ft. from W. Line

STOLTENBERG POOL

RECORD

Location _____

Rig up _____

Drilling and Remarks:

cu 3295
5" @ 3307
2000 acid
Depth Per 5428
Max 3000
44° SW

Cased _____ in., _____ ft.

Sand _____

Gas _____

Oil _____

Total Depth *3319*

PRODUCTION

1st 24 hrs. Nat. _____

1st 24 hrs. after shot _____

Gas _____ Cu. Ft.

Dry Hole _____

Abandoned _____

Date

JUL 30 1941 19

S. J. LEWIS Scout