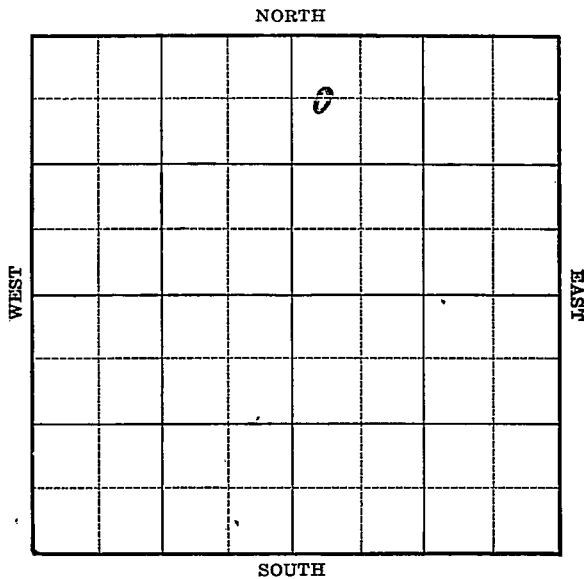


Section 8 Township 16 Range 10WWell No. #6 TalskyCompany Beardmore Drlg.

KANSAS

Ellsworth

Sec. 8 Twp. 16 R. 10-WWell No. #6 Talsky Farm

Beardmore Drlg.

Company

(Stoltenberg)


660 Ft. from N. Line

Ft. from S. Line

Ft. from E. Line

330 Ft. from W. Line

Elev. 1848

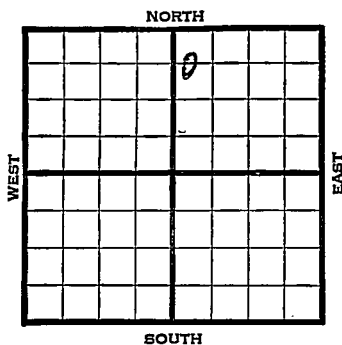

1940	REPORT
10/16	Material.
10/24	R.U.R.
10/31	8" - 309' Drlg. 2662'
11/7	Arb. 3309' 5" - 3309' RUST.
11/14	T.D. 3322' 250' oil 8 hrs.
	2000 acid.
11/21	P.B. 3317'
11/27	" "
12/5	Pump 53 bbls. oil. No water.
12/12	" " " "
12/19	" " " "
12/26	Shut down.
1941	
1/2	" "
1/9	" "
1/16	" "
1/23	" "
1/30	" "
	OVER

1941
2/5

Arb. 3309'.

5" - 3309'

T.D. 3318'

2000 acid.

Potential 120 bbls., pump.

44. Gravity

COMPLETED

Map No. 55 Sec. 8 Twp. 16 R. 10WWell No. 6 TalskyBeardmore Drlg. Company

Contractor

FIRST REPORT660 C W L NW NE
Ft. from N. Line

Ft. from S. Line

Ft. from E. Line

330 Ft. from W. Line**STOLTENBERG POOL****SECTION PLAT**

		o	

Location _____

Rig up _____

Drilling and Remarks:

Material

RECORD

Cased _____ in., _____ ft.

Sand _____

Gas _____

Oil _____

Total Depth _____

PRODUCTION

1st 24 hrs. Nat. _____

1st 24 hrs. after shot _____

Gas _____ Cu. Ft.

Dry Hole _____

Abandoned _____

Date

OCT 16 1940

19

S. J. LEWIS

Scout

Map No. 55 Sec. 8 Twp. 16 R. 10WWell No. 6 TalskyBeardmore Drilling CompanyCOMPLETED Contractor

SECTION PLAT

		6	

C W L NW NE

660 Ft. from N. Line Ft. from S. Line Ft. from E. Line330 Ft. from W. Line

STOLTENBERG POOL

Location Rig up

Drilling and Remarks:

*Ac 42309**5" 42309**2000 acid**Pump. 120 B.D.**44 2 Gr.*

RECORD

Cased in., ft.Sand Gas Oil Total Depth 3318

PRODUCTION

1st 24 hrs. Nat. 1st 24 hrs. after shot Gas Cu. Ft.Dry Hole Abandoned

Date

FEB 5 1941 19

S. J. LEWIS Scout