

KANSAS

Form 51-5M-7-40-Palace


Ellsworth

Section 8 Township 16 Range 10-W

Well No. 7 Talsky

Company Breadmore Drilling

NORTH Stoltenberg Pool

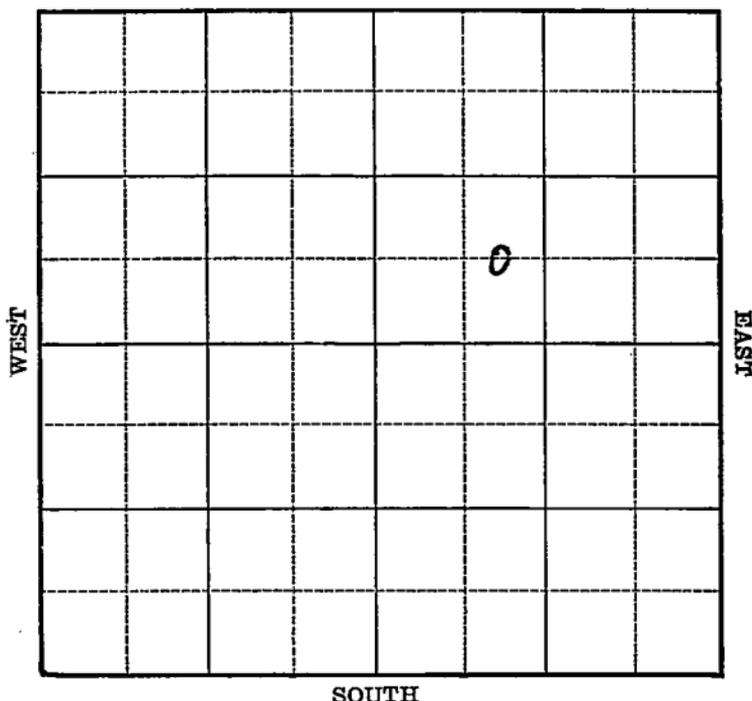


7

Sec. 8 Twp. 16 R. 10-WWell No. #7 Talsky FarmBeardmore Drilling Company

(Stoltenberg)

 Ft. from N. Line660 Ft. from S. Line Ft. from E. Line920 Ft. from W. Line

Elev. 1800

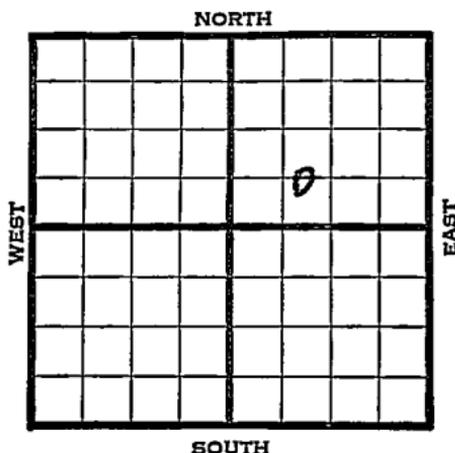

1941

REPORT

2/19 Derrick.

2/27 "

3/6 Rigging up.

3/13 " "

3/20 10" - 300'

Drlg. 964'

3/27 Drlg. 2765'

4/2 Arb. 3264' 7" - 3265'

T.D. 3280' 250' oil 12 hours.

1000 acid.

4/10 3000' oil.

4/16 Arb. 3264'

T.D. 3280'

1000 acid.

Minimum well 15 bbls.

44. Gravity

COMPLETED

Map No. _____ Sec. 8 Twp. 16 R. 10WWell No. 7 TalskyBeardmore Drilling Company**FIRST REPORT**

Contractor

C E L S W N E

_____ Ft. from N. Line

660 Ft. from S. Line

_____ Ft. from E. Line

990 Ft. from W. Line

STOLTENBERG POOL

SECTION PLAT

		o	

Location _____

Rig up _____

Drilling and Remarks:

Derrick

RECORD

Cased _____ in., _____ ft.

Sand _____

Gas _____

Oil _____

Total Depth _____

PRODUCTION

1st 24 hrs.-Nat. _____

1st 24 hrs. after shot _____

Gas _____ Cu. Ft.

Dry Hole _____

Abandoned _____

Date

FEB 19 1941 19S. J. LEWIS Scout

Map No. 55 Sec. 8 Twp. 16 R. 10W

Well No. 7 Talsky

Beardmore Drilling Company

Contractor

COMPLETED

C E L SW NE

_____ Ft. from N. Line

660 Ft. from S. Line

_____ Ft. from E. Line

990 Ft. from W. Line

STOLTENBERG POOL

SECTION PLAT

		o	

Location _____

Rig up: _____

Drilling and Remarks:

1000 acid

Min. Well

15 Hbbs

44 Gall.

RECORD

Cased _____ in., _____ ft.

Sand *barbuckle 3264*

Gas _____

Oil _____

Total Depth *3280*

PRODUCTION

1st 24 hrs. Nat. _____

1st 24 hrs. after shot _____

Gas _____ Cu. Ft.

Dry Hole _____

Abandoned _____

Date

APR 16 1941

19

S. J. LEWIS

Scout