

Section 9 Township 16 Range 10WWell No. #1 BoveCompany Harms & Knight

NORTH

SOUTH

WEST

EAST

0

13

KANSAS

Ellsworth

Sec. 9 Twp. 16 R. 10W

Well No. #1 Boye Farm

Harms & Knight Company
Kraft-Prusa (Harms & Knight, Contr.)

 Ft. from N. Line

200'


 Ft. from S. Line

 Ft. from E. Line

200'

 Ft. from W. Line

SW/C

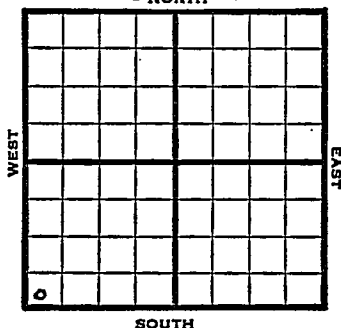

1949	REPORT
12/28	Br. Lime 2990' Lans. 3010' Simp. 3316' Arb. 3328-30 TD 5" @ 3328' Swb 40% oil 60% wtr D&A TD 3330' FIRST REPORT ABANDONED

Map No. _____ Sec. 9 Twp. 16 R. 10W

Well No. 1 Bove

Harms & Knight Company

Harms & Knight Contractor

SW/C


E11849
SECTION PLAT

_____ Ft. from N. Line

200 Ft. from S. Line

_____ Ft. from E. Line

200 Ft. from W. Line

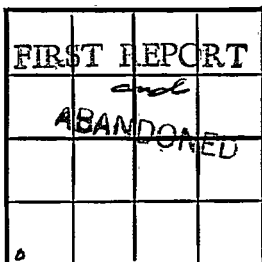

Ellsworth County

Location _____

Rig up _____

Drilling and Remarks:

Br. lime 2990

Lans. 3010

Simp. 3316

Arb. 3328-30 TD

5" @ 3328

swb. 40% oil

60 % water

D & A

RECORD

Cased _____ in., _____ ft.

Sand _____

Gas _____

Oil _____

Total Depth 3320

PRODUCTION

1st 24 hrs. Nat. _____

1st 24 hrs. after shot _____

Gas _____ Cu. Ft.

Dry Hole _____

Abandoned _____

Date

DEC 28 1949

19

S. J. LEWIS

Scout