
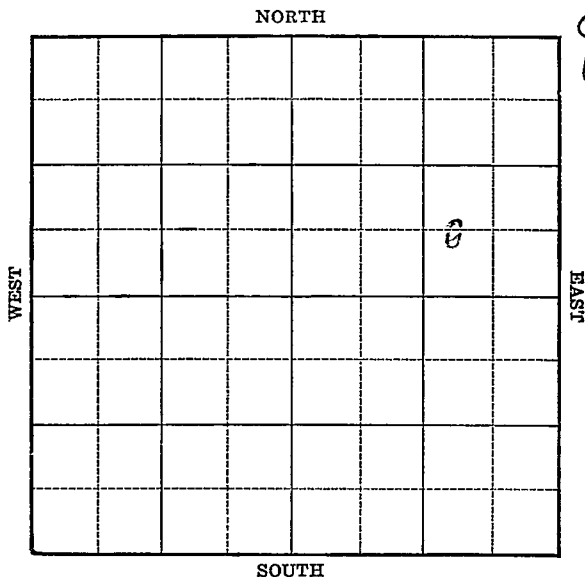


Section 8 Township 16 Range 10W

Well No. #3 Talsky

Company Beardmore Drilling et al

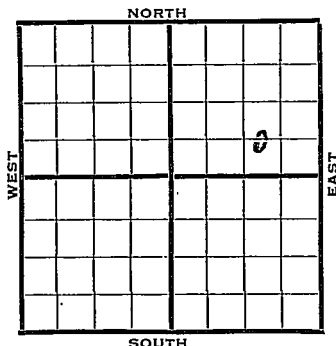

[illegible]

Map No. 55 Sec. 8 Twp. 16 R. 10WWell No. 3 TalskyBeardmore Drilling et al Company

Contractor

FIRST REPORT

C W L S E N E

Ft. from N. Line

660

Ft. from S. Line

990

Ft. from E. Line

Ft. from W. Line

STOLTENBERG POOL

SECTION PLAT

			0

Location

Rig up

Drilling and Remarks:

Derrick

RECORD

Cased _____ in., _____ ft.

Sand _____

Gas _____

Oil _____

Total Depth _____

PRODUCTION

1st 24 hrs. Nat. _____

1st 24 hrs. after shot _____

Gas _____ Cu. Ft.

Dry Hole _____

Abandoned _____

Date

JUL 17 1940

19

S. J. LEWIS Scout

Map No. 55 Sec. 8 Twp. 16 R. 10WWell No. 3 TalskyBeardmore Drilling et al Company

Contractor

COMPLETED**SECTION PLAT**

C W L SE NE

 Ft. from N. Line660 Ft. from S. Line990 Ft. from E. Line Ft. from W. Line**STOLTENBERG POOL**

			o

Location Rig up

Drilling and Remarks:

*Ac 83270**5" 03280**2000 ac 0**Echometer 24*
*4886.**May 13 1940***RECORD**Cased in., ft.Sand Gas Oil Total Depth 3302**PRODUCTION**1st 24 hrs. Nat. 1st 24 hrs. after shot Gas Cu. Ft.Dry Hole Abandoned

Date

AUG 7 1940S. J. LEWIS

Scout