

KANSAS

Form 51-5M-7-39-Palace


Ellsworth

Section 8 Township 16 Range 10-W

Well No. #2 Talsky

Company Beardmore et al

NORTH Stoltenberg Pool

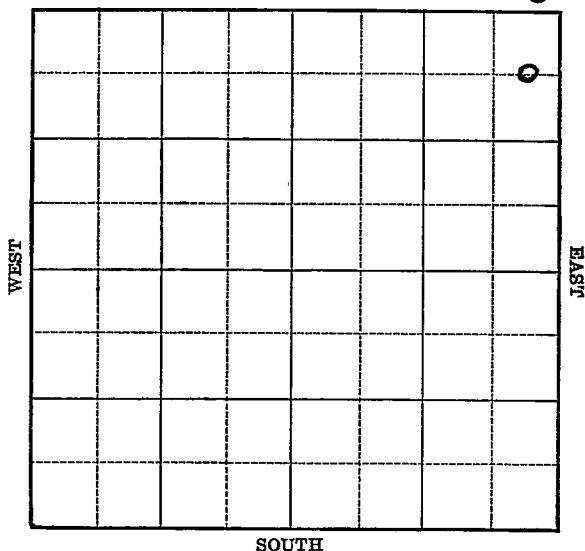

Map No. 55 Sec. 8 Twp. 16 R. 10WWell No. 2 TalskyBeardmore et al

Company

Contractor

FIRST REPORT

SECTION PLAT

660 C E L N E N E
Ft. from N. Line

Ft. from S. Line

330 Ft. from E. Line

Ft. from W. Line

STOLTENBERG POOL

			o

Location _____

Rig up _____

Drilling and Remarks:

Cellar

RECORD

Cased _____ in., _____ ft.

Sand _____

Gas _____

Oil _____

Total Depth _____

PRODUCTION

1st 24 hrs. Nat. _____

1st 24 hrs. after shot _____

Gas _____ Cu. Ft.

Dry Hole _____

Abandoned _____

Date

JUN 5 1940 19

S. J. LEWIS Scout

Map No. 55 Sec. 8 Twp. 16 R. 10WWell No. 2 TalskyBeardmore etal

Company

Contractor

COMPLETED

C E L N E N E

660 Ft. from N. Line Ft. from S. Line330 Ft. from E. Line Ft. from W. Line

STOLTENBERG POOL

SECTION PLAT

			0

Location Rig up

Drilling and Remarks:

*Cor 8.3244**5" @ 8245**1000 acid**Depthograph Pot**21111**Max 3000***RECORD**Cased in., ft.Sand Gas Oil Total Depth 3257**PRODUCTION**1st 24 hrs. Nat: 1st 24 hrs. after shot Gas Cu. Ft.Dry Hole Abandoned

Date

JUL 2 1940 19

S. J. LEWIS Scout