

Sec. 8 Twp. 16 R. 10-W

Well No. #5 Talsky Farm
Beardmore et al Company

(Stoltenberg)


660 Ft. from N. Line

_____ Ft. from S. Line

_____ Ft. from E. Line

990 Ft. from W. Line

Elev. 1810

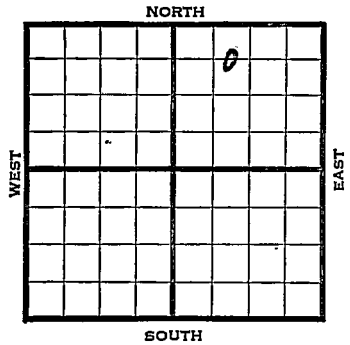

1940	REPORT
10/2	Rotary.
10/10	8" - 313' Anhy 605'
	Drlg. 1280'
10/17	Arb. 3274-76' T.D. 5" - 3273'
	RUST.
10/24	T.D. 3289' 3000' oil.
10/31	4000 acid. Pump 17 bbls. per hour 6 hours.
11/7	Shot 30 qts. on bottom. Swab 20 bbls. 1' hour.
11/14	" " "
11/21	" " "
11/27	" " "
12/5	" " "
12/11	Arb. 3273'
	5" - 3273'
	T.D. 3289'
	Shot 30 qts.
	4000 acid.
	Echometer potential 2277 bbls.
	44. gravity COMPLETED

Map No. 55 Sec. 8 Twp. 16 R. 10WWell No. 5 TalskyBeardmore etal Company

Contractor

FIRST REPORT

C E L N W N E

660 Ft. from N. Line

_____ Ft. from S. Line

_____ Ft. from E. Line

990 Ft. from W. Line

SECTION PLAT

		o	

STOLTENBERG POOL

Location _____

Rig up _____

Drilling and Remarks:

Rotary

RECORD

Cased _____ in., _____ ft.

Sand _____

Gas _____

Oil _____

Total Depth _____

PRODUCTION

1st 24 hrs. Nat. _____

1st 24 hrs. after shot _____

Gas _____ Cu. Ft.

Dry Hole _____

Abandoned _____

Date

OCT 2 1940

S. J. LEWIS Scout

Map No. 55 Sec. 8 Twp. 16 R. 10WWell No. 5 TalskyBeardmore etal Company

Contractor

COMPLETED

C E L NW NE

660 Ft. from N. Line Ft. from S. Line Ft. from E. Line990 Ft. from W. Line

STOLTENBERG POOL

SECTION PLAT

Location _____

Rig up _____

Drilling and Remarks:

*Cr & 3273**5" C 3273**309 to**4000 acid**Echo Pot 3277**440 Se***RECORD**

Cased _____ in., _____ ft.

Sand _____

Gas _____

Oil _____

Total Depth 3289**PRODUCTION**

1st 24 hrs. Nat. _____

1st 24 hrs. after shot _____

Gas _____ Cu. Ft.

Dry Hole _____

Abandoned _____

Date

DEC 11 1940 19S. J. LEWIS Scout