

KANSAS


FORM 51 5M 1-42 PETROL

Ellsworth

Section 8 Township 16 Range 10-W


Well No. #6 Svoboda

Company Gulf

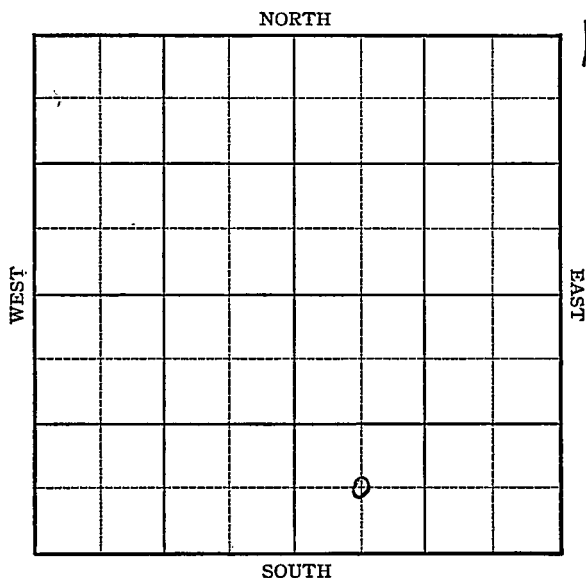

Sec. 8 Twp. 16 R. 10-WWell No. #6 Svoboda FarmGulf Company

NORTH

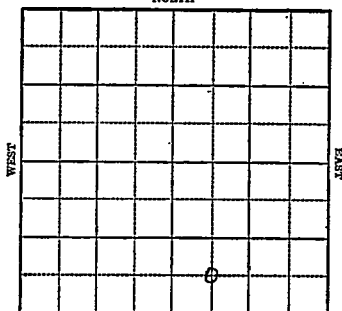

SOUTH

 Ft. from N. Line660 Ft. from S. Line Ft. from E. Line660 Ft. from W. Line*Elev. 1841*

1943

R E P O R T

5/5 Location

5/12 "

5/19 9" @ 310
T.D. 675 SD

5/26 Drlg. 2520'

6/2 2846 lost circulation.

6/9 Arb 3309
7" @ 3310
T.D. 3330 SO6/16 Arb. 3309'
7" @ 3310'
T.D. 3330'
1000 acid
Pump 128 oil plus 130 water pot.
Gravity 42.8

COMPLETED

KANSAS

Map No. 55 Sec. 8 Twp. 16 R. 10WWell No. 6 Svoboda

Gulf

Company

FIRST REPORT

Contractor

C SW SE

SECTION PLAT

		o	

Ft. from N. Line

660

Ft. from S. Line

Ft. from E. Line

660

Ft. from W. Line

STOLTENBERG POOL

Location XX

Rig up

Drilling and Remarks:

RECORD

Cased _____ in. _____ ft.

Sand _____

Gas _____

Oil _____

Total Depth _____

PRODUCTION

1st 24 hrs. Nat. _____

1st 24 hrs. after shot _____

Gas _____ Cu. Ft.

Dry Hole _____

Abandoned _____

Date

MAY 5 1943 19

S. J. LEWIS

Scout

KANSAS

Ellsworth

Map No. 33 Sec. 8 Twp. 16 R. 10WWell No. 6 Svoboda

Gulf

Company

COMPLETED

Contractor

C SW SE

SECTION PLAT

		o	

 Ft. from N. Line660 Ft. from S. Line Ft. from E. Line660 Ft. from W. Line

STOLTENBERG POOL

Location Rig up

Drilling and Remarks:

*Cor 83309**7" @ 3310**1000 acid**Pump 125 oil + 130**Watered P & 8**42 E. 1/2*

RECORD

Cased in., ft.Sand Gas Oil Total Depth 3330

PRODUCTION

1st 24 hrs. Nat. 1st 24 hrs. after shot Gas Cu. Ft.Dry Hole Abandoned

Date

JUN 16 1943 19

S. J. LEWIS Scout