



Sec. 36 Twp. 25 R. 4E

Well No. #19 Ralston - Robinson Farm

Cities Service Company


Miscellaneous

Ft. from N. Line

990' Ft. from S. Line

Ft. from E. Line

990' Ft. from W. Line

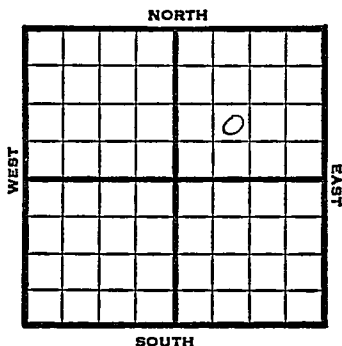

NE SW NE

1949 Elev 1396' REPORT

6/15 Location

6/21 10" @ 81'
Drlg. 1164'

6/28 Arbuckle 2424'
TD 2426'
5" @ 2424'

7/6 TD 2451'
Arb. 2424'
5" @ 2424'
Pump 29 Oil Pot
38° Gr.
Comp

COMPLETED

Butler County Kansas State

Map No. _____ Sec. 36 Twp. 25 R. 4E

Well No. 19 Ralston - Robinson

Cities Service Company

Contractor

NE SW NE

FIRST REPORT SECTION PLAT

_____ Ft. from N. Line

990 Ft. from S. Line

_____ Ft. from E. Line

990 Ft. from W. Line

					6		

Miscellaneous

Remarks:

Location

Date

JUN. 15 1949

Scout

S. J. LEWIS

