

KANSAS

Butler

Section 36 Township 25 Range 4E

Well No. 42 Huston

Company Cities Service

Misc.

NORTH

					0		

WEST

EAST

SOUTH

Butler

KANSAS ✓

Sec. 36 Twp. 25 R. 4E

Well No. #42 Huston Farm _____

Cities Service

Company _____

Miscellaneous


950' Ft. from N. Line

_____ Ft. from S. Line

_____ Ft. from E. Line

1045' Ft. from W. Line

SE NW NE

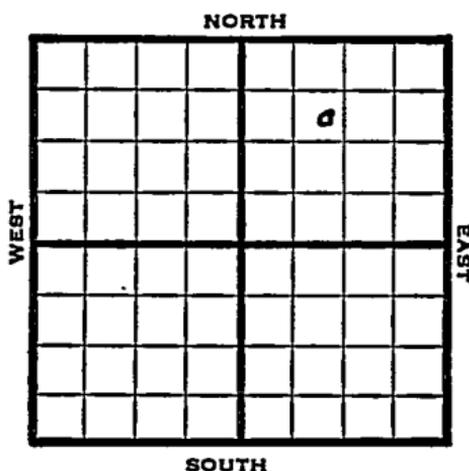

1949 Elev 1384' REPORT

7/20 8" @ 85'
7/27 Lansing 1721'
KC 1999(
Drlg 2405'
8/3 Arbuckle 2427'
5" @ 2427'
TD 2747'
300' oil 13 hrs.
8/10 TD 2447'
Arb. 2427'
5" @ 2427'
500 acid
Pump 114 Oil Pot
38° Gr.
Comp

COMPLETED

Map No. _____ Sec. 36 Twp. 25 R. 4E

Well No. 42 Huston

_____ Cities Service _____ Company

_____ Contractor

SE NW NE

**FIRST REPORT
SECTION PLAT**

950 Ft. from N. Line

_____ Ft. from S. Line

_____ Ft. from E. Line

1045 Ft. from W. Line

		o	

Butler County

Location _____

Rig up _____

Drilling and Remarks: _____

8" @ 85

RECORD

Cased _____ in., _____ ft.

Sand _____

Gas _____

Oil _____

Total Depth _____

PRODUCTION

1st 24 hrs. Nat. _____

1st 24 hrs. after shot _____

Gas _____ Cu. Ft.

Dry Hole? _____

Abandoned _____

Date

JUL 20 1949 19_____

S. J. LEWIS

Scout

Kansas

Map No. K12 Sec. 36 Twp. 25 R. 4EWell No. 42 Huston

Cities Service

Company

COMPLETE

Contractor

SE NW NE

E11384
SECTION PLAT950 Ft. from N. Line

_____ Ft. from S. Line

_____ Ft. from E. Line

1045 Ft. from W. Line

Butler County

RECORD

Location _____

Cased _____ in., _____ ft.

Rig up _____

Sand _____

Drilling and Remarks:

Gas _____

Oil _____

Total Depth 2447**PRODUCTION**

1st 24 hrs. Nat. _____

1st 24 hrs. after shot _____

Gas _____ Cu. Ft.

Dry Hole _____

Abandoned _____

Date

AUG 10 1949 19S. J. LEWIS

Scout