

Form 51-5M-7-39-Palace


Ellsworth

Section 9 Township 16 Range 10-W

Well No. #1 Boye

Company Aylward Production

NORTH ~~Stoltenberg~~ Pool

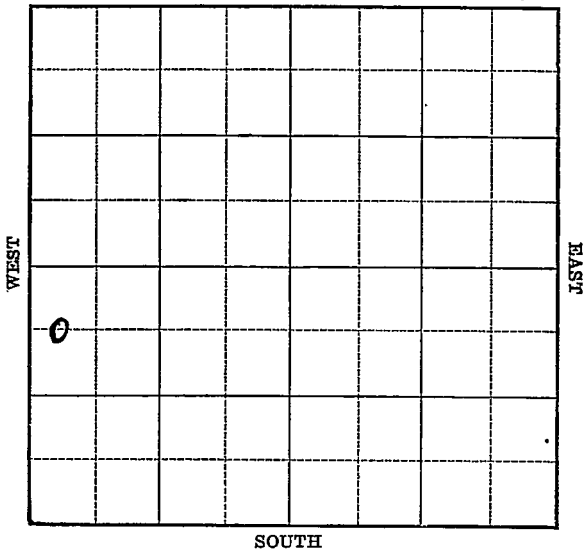


KANSAS**Ellsworth**Sec. 9 Twp. 16 R. 10-WWell No. #1 Boye FarmAylward Prod. Company

(Stoltenberg)

660 Ft. from N. Line Ft. from S. Line Ft. from E. Line330 Ft. from W. Line

Elev. 1894

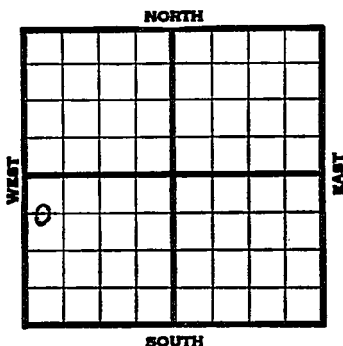

1940

REPORT

2/7 R.O.G.

2/15 Surface hole.

2/23 8 $\frac{1}{4}$ " - 280' Drlg. 1416'

2/29 Anhy 650' Drlg. 2785'

3//8 Lansing 3035' Simp. 3349'

Arb. 3360-61' T.D. S.O.

5" - 3360' WOC.

3/14 " " "

3/21 T.D. 3369' Pump 56 bbls. in 7
hours.

3/27 Arb. 3360'

5" - 3360'

T.D. 3369'

Depthograph potential 10,021 bbl

Maximum 3000 bbls.

COMPLETED

Map No. 53 Sec. 9 Twp. 16 R. 10WWell No. 1 BoyeAylward Production Company

Contractor

FIRST REPORT**C W $\frac{1}{2}$ NW SW**660 Ft. from N. Line Ft. from S. Line Ft. from E. Line330 Ft. from W. Line**STOLTENBERG POOL****SECTION PLAT**

o			

Location Rig up

Drilling and Remarks:

R.O.G.**RECORD**Cased in., ft.Sand Gas Oil Total Depth **PRODUCTION**1st 24 hrs. Nat. 1st 24 hrs. after shot Gas Cu. Ft.Dry Hole Abandoned

Date

FEB 7 1940 19

S. J. LEWIS

Scout

Map No. 55 Sec. 9 Twp. 16 R. 10WWell No. 1 BoyeAylward Production Company

Contractor

COMPLETED

C $W\frac{1}{2}$ NW SW660 Ft. from N. Line Ft. from S. Line Ft. from E. Line330 Ft. from W. Line

SECTION PLAT

0			

STOLTENBERG POOL

Location Rig up

Drilling and Remarks:

*Cor 83360**5" @ 3360**Depthograph 1002**Maximum 3000.*

RECORD

Cased in., ft.Sand Gas Oil Total Depth 3369

PRODUCTION

1st 24 hrs. Nat. 1st 24 hrs. after shot Gas Cu. Ft.Dry Hole Abandoned

Date

MAR 27 1940

S. J. LEWIS Scout