

Ellsworth


KANSAS

SECTION 9 TOWNSHIP 16 RANGE 10W

WELL NO. #1 Boye

COMPANY Grant Oil

NORTH C N $\frac{1}{2}$ NE NE SW

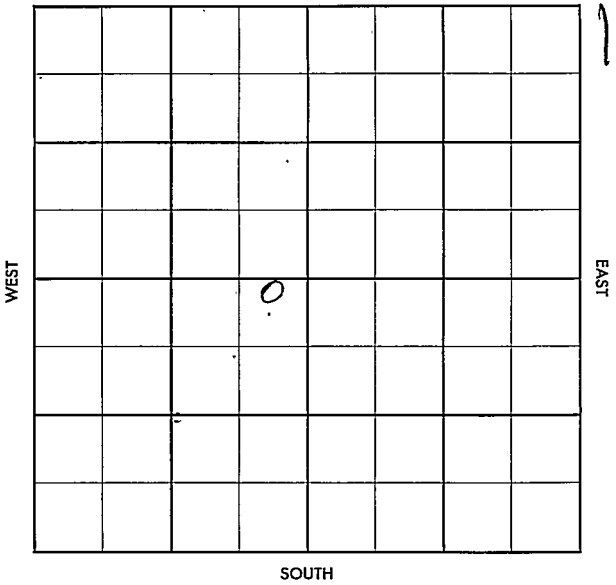

County Ellsworth

Elev. _____

Sec. 9 Twp. 16Rge. 10WCompany Grant OilFarm Name BoysNo. 1

TOPS

DEPTH

LOG

DATUM

Anh.

T.P.

H.

Tr.

Dg.

Bl.

L.

K.C.

B.K.C.

Ce.

C.

M.

M.

K.

Mz.

Mo.

V.

S.

S.

A.

R.

P.E.

G.

T.D.

Loc. in Sec. _____

C N $\frac{1}{2}$ NE NE SW

Geol. _____

Contr. _____

B & B

Pool _____

Stoltenberg

FIRST REPORT	
JUL 24 '57	

Date Comm. 7-14-578" @ 310 drlg. 3087

County Ellsworth Elev. 1812
 Sec. 9 Twp. 16 Rge. 10W
 Company Grant Oil
 Farm Name Boye No. 1

TOPS	DEPTH	LOG	DATUM	Loc. in Sec.
Anh.				C N $\frac{1}{2}$ NE NE SW
TP.	2545			
H.	2847			
Tr.	2861			
Dg.				
BL.	2944			
L.				Geol.
K.C.	2959			Contr.
B.K.C.				B & B
Ce.				
C.				Pool
M.				Stoltenberg
M.				
K.				
Mz.				
Mq.				
V.				
S.				
S.				
A.	3290			
R.				
Pe.				
G.				
T.D.	3293			

ABANDONED

JUL 31 57

Date Comm. 7-14-57
8" @ 310 drlg. 3087 JUL 3 57 DST

3285-93 2 hrs 830' sulph wtc
415/20

DFA