

KANSAS

Form 51--5M--11-38--Palace


Ellsworth

Section 9 Township 16 Range 10-W

Well No. #1 Boye

Company Duwe, Farris et al

NORTH **Stoltenberg Pool**

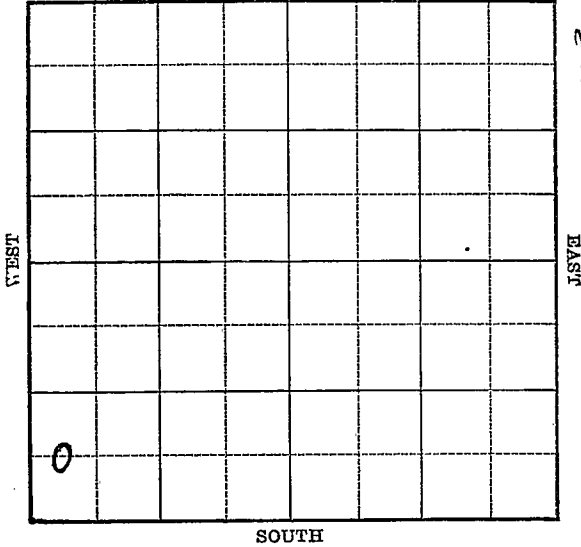

Sec. 9 Twp. 16 R. 10-W

Well No. #1 Boye Farm _____

Duwe, Farris et al Company _____


(Stoltenberg)

_____ Ft. from N. Line

660 Ft. from S. Line

_____ Ft. from E. Line

330 Ft. from W. Line

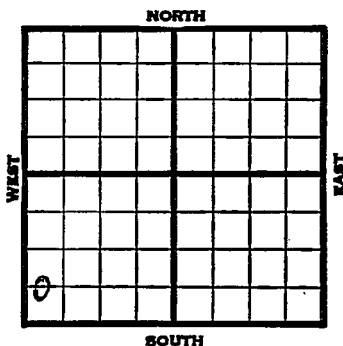

Elev. 1884

1939	REPORT
11/1	11" - 357' WOC.
11/9	Anhy 670' Drlg. 2400'
11/16	Ft. Riley 1630' Florence 1750' Topeka 2680' Drlg. 2800'
11/23	Lans. 3011' Arb. 3365' T.D. 3371' Run pipe. S.O.
11/29	" " " " "
12/7	5" - 3365' T.D. 3372' 2000' oil. Shut down.
12/14	" " " "
12/21	" " " "
12/27	Arb. 3365'
	5" - 3365'
	T.D. 3372'
	1000 acid.
	Depthograph potential 6188 bbls.
	Maximum 3000 bbls.
	COMPLETED

Map No. 55 Sec. 9 Twp. 16 R. 10WWell No. 1 BoyeDuwe, Farris etal

Company

Contractor

FIRST REPORT

C W L SW SW

_____ Ft. from N. Line

660 Ft. from S. Line

_____ Ft. from E. Line

330 Ft. from W. Line

SECTION PLAT

STOLTENBERG POOL

Location _____

Rig up _____

Drilling and Remarks:

11" - 357WOC

RECORD

Cased _____ in., _____ ft.

Sand _____

Gas _____

Oil _____

Total Depth _____

PRODUCTION

1st 24 hrs. Nat. _____

1st 24 hrs. after shot _____

Gas _____ Cu. Ft.

Dry Hole _____

Abandoned _____

Date

NOV 1 1939 19

S. J. LEWIS Scout

Map No. 55 Sec. 9 Twp. 16 R. 10WWell No. 1 BoyeDuwe, Harris et al Company

Contractor

COMPLETED

C W L SW SW

SECTION PLAT

 Ft. from N. Line660 Ft. from S. Line Ft. from E. Line330 Ft. from W. Line

STOLTENBERG POOL

Location Rig up

Drilling and Remarks:

*at 3365'**5" @ 3365'**1000 acid**Depthograph P.D.**6188**Maximum 3000***RECORD**Cased in., ft.Sand Gas Oil Total Depth 3372**PRODUCTION**1st 24 hrs. Nat. 1st 24 hrs. after shot Gas Cu. Ft.Dry Hole Abandoned

Date

DEC 27 1939

19

S. J. LEWIS Scout