

Section 9 Township 16 Range 10W


Well No. #1 Boye

Company H. E. Alexander & Saline Drig.

NORTH

WEST

EAST

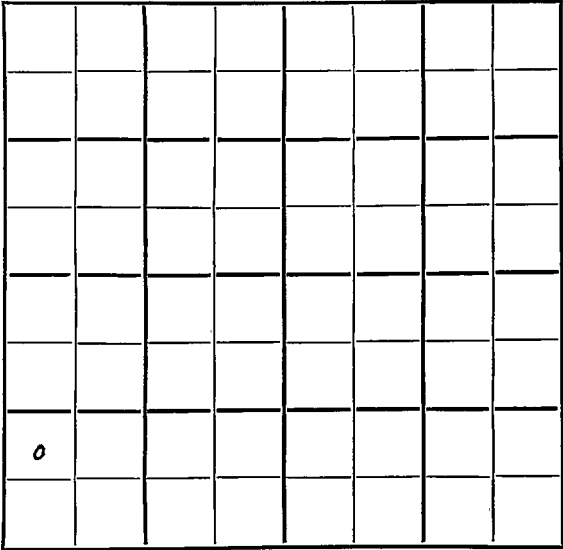

SOUTH

13

0

Sec. 9 Twp. 16 R. 10 W

Well No. # 1 Boye Farm

H.E. Alexander & Saine Drlg. Company

Contractor


Ft. from N. Line

1200 Ft. from S. Line

Ft. from E. Line

450 Ft. from W. Line

NW SW SW

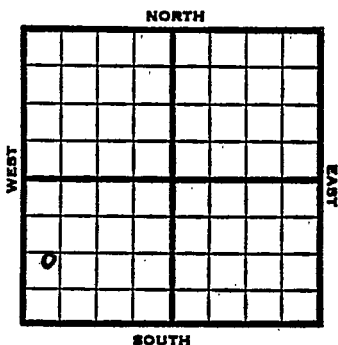

1953 Elev. 1895' REPORT

2/4 Spud 1-18-53  
 8" @ 260 Heeb 2935' Tor 2954'  
 B. Oread 2963' Br. Lime 3035'  
 KC 3053' B KC 3347' Simp. 3359'  
 Simp. sd 3361' Arb. 3382'  
 TD 3384' 4 1/2" @ 3383 WOC

2/12 WOC

2/19 "

2/26 "

3/12 NR

3/19 NR

3/26 NR

4/2 NR

4/9 NR

4/16 NR

4/23 "

4/30 "

5/7 "

5/13 Spud 1-18-53  
 Oil Well  
 TD 3386'  
 8" @ 260'

OVER

1953

Information brought forward

5/13

Heeb 2935, Tor 2954, B: Oread 2963,  
Br. Lime 3035, KC 3053, B. KC 3347,  
Simp 3359, Simp Sd. 3361, Arb 3382  
TD 3384:

4 $\frac{1}{2}$ " @ 3383:

DD. 3386:

FU 2100' fluid 7 hr. mostly wtr.

PB 3380 Perf/ 3359-61 9/ 3361-63

15/ 3363-68 S/ 5 goph 1 $\frac{1}{2}$  gwph

500 A sd-frac F/ 4 $\frac{1}{2}$  boph 8 hr.

P/ 55 bopd dec. to 10 bopd.

Comp. 10 bopd.

**COMPLETED**



