

# KANSAS

Ellsworth


Form 51-5M-7-40-Palace

Section 9 Township 16 Range 10-W

Well No. #2 Boye

Company Duwe & Farris et al

NORTH Stoltenberg Pool

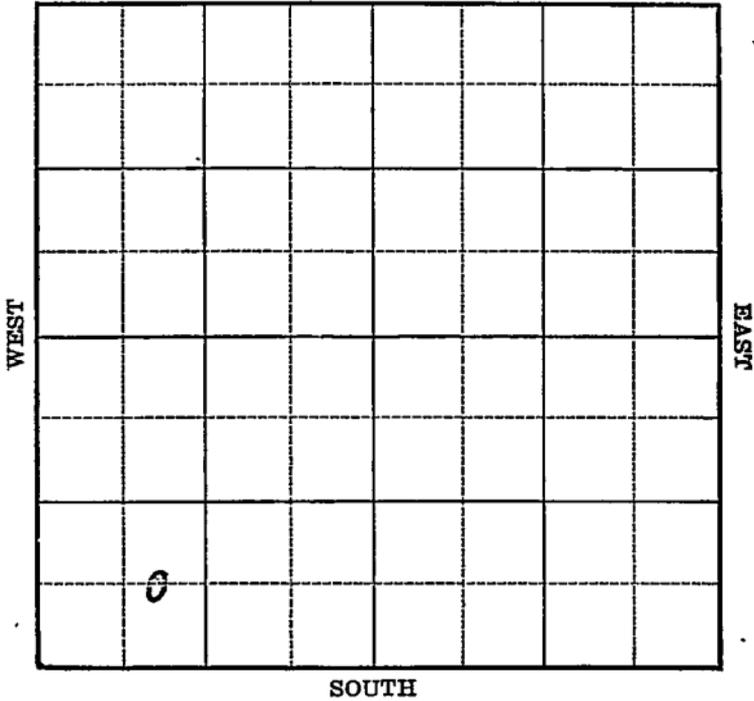

Sec. 9 Twp. 16 R. 10-W

Well No. #2 Boye Farm

Duwe & Farris et al Company

(Stoltenberg)


~~660~~ Ft. from N. Line

660 Ft. from S. Line

\_\_\_\_\_ Ft. from E. Line

990 Ft. from W. Line

Elev. 1865

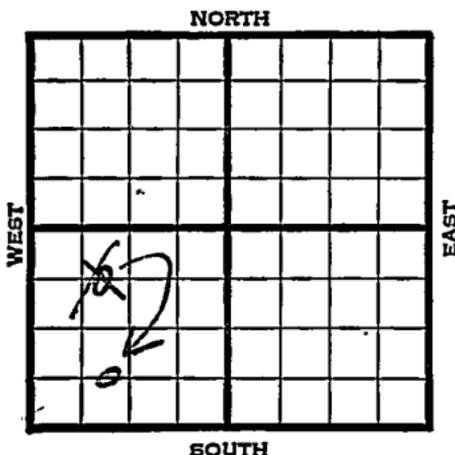

| 1940  | REPORT  |
|-------|---|
| 12/18 | Derrick.  |
| 12/26 | Rigging up.   |
| 1941  |   |
| 1/2   | " "   |
| 1/9   | Drig. 2000'   |
| 1/16  | 8" - 361' Lans. 3012'   |
|       | Drig. 3195'   |
| 1/23  | Arb. <del>3353</del> <sup>3356</sup> T.D. 3358' Sat.<br>Waiting on 5".  |
| 1/30  | Arb. <del>3357</del> <sup>3356</sup> (Corrected)<br>T.D. <del>3363</del> <sup>3362</sup> 5" - <del>3359</del> <sup>3357</sup> RUST. |
| 2/6   | Arb. 3356' (Corrected)  |
|       | T.D. 3362' 5" - 3357'   |
|       | 2850' oil.  |
|       |   |
|       |   |
|       |   |
|       | <b>OVER</b>   |
|       |   |
|       |   |
|       |   |

1941  
2/12

Arb. 3356'

5" - 3357'

T.D. 3362'

Echometer potential 2712. bbls.

44. Gravity

COMPLETED

Map No. \_\_\_\_\_ Sec. 9 Twp. 16 R. 10W

Well No. 2 Boye

Duwe & Farris etal Company

Contractor

**FIRST REPORT**

C E L NW SW

660 Ft. from N. Line

\_\_\_\_\_ Ft. from S. Line

\_\_\_\_\_ Ft. from E. Line

990 Ft. from W. Line

**STOLTENBERG POOL**

**SECTION PLAT**

|   |   |  |  |
|---|---|--|--|
|   |   |  |  |
|   |   |  |  |
|   |   |  |  |
| o |   |  |  |
| c | o |  |  |

Location \_\_\_\_\_

Rig up \_\_\_\_\_

Drilling and Remarks:  
**Derrick**

**RECORD**

Cased \_\_\_\_\_ in., \_\_\_\_\_ ft.

Sand \_\_\_\_\_

Gas \_\_\_\_\_

Oil \_\_\_\_\_

Total Depth \_\_\_\_\_

**PRODUCTION**

1st 24 hrs. Nat. \_\_\_\_\_

1st 24 hrs. after shot \_\_\_\_\_

Gas \_\_\_\_\_ Cu. Ft.

Dry Hole \_\_\_\_\_

Abandoned \_\_\_\_\_

Date

DEC 18 1940 19

**S. J. LEWIS**

Scout

Aylward #2 here



|                  |            |
|------------------|------------|
| Misc. Small Maps | <i>Ray</i> |
| Cards            | <i>Ray</i> |
| Tracing          | <i>Ray</i> |
| France Map       | <i>Ray</i> |
| Scarborough Map  | <i>Ray</i> |
| Moody Map        | <i>Ray</i> |
| Geological Dept. |            |
| Moody Flat Book  |            |

Map No. 55 Sec. 9 Twp. 16 R. 10W

Well No. 2 Bove

Duwe & Farris etal Company

CORRECTION Contractor

C E L S W S W

\_\_\_\_\_ Ft. from N. Line

660 Ft. from S. Line

\_\_\_\_\_ Ft. from E. Line

990 Ft. from W. Line

STOLTENBERG POOL

**SECTION PLAT**

|  |  |  |  |
|--|--|--|--|
|  |  |  |  |
|  |  |  |  |
|  |  |  |  |
|  |  |  |  |

Location \_\_\_\_\_

Rig up \_\_\_\_\_

Drilling and Remarks:

Reported

C E L N W S W

**RECORD**

Cased \_\_\_\_\_ in., \_\_\_\_\_ ft.

Sand \_\_\_\_\_

Gas \_\_\_\_\_

Oil \_\_\_\_\_

Total Depth \_\_\_\_\_

**PRODUCTION**

1st 24 hrs. Nat. \_\_\_\_\_

1st 24 hrs. after shot \_\_\_\_\_

Gas \_\_\_\_\_ Cu. Ft.

Dry Hole \_\_\_\_\_

Abandoned \_\_\_\_\_

Date

DEC 23 1940 19

S. J. LEWIS Scout

Map No. 55 Sec. 9 Twp. 16 R. 10WWell No. 2 BoyeDuwe & Farris etal Company

Contractor

**COMPLETED**

C E L SW SW

         Ft. from N. Line660 Ft. from S. Line         Ft. from E. Line990 Ft. from W. Line**SECTION PLAT**

|   |  |  |  |
|---|--|--|--|
|   |  |  |  |
|   |  |  |  |
|   |  |  |  |
| o |  |  |  |

STODTENBERG POOL

Location                                 Rig up                                 

Drilling and Remarks:

*Co. X 3356**5" @ 3357**Ech. Pt. 27 1/2**H. G. G.***RECORD**Cased          in.,          ft.Sand                                 Gas                                 Oil                                 Total Depth 3362**PRODUCTION**1st 24 hrs. Nat.                         1st 24 hrs. after shot                         Gas                                  Cu. Ft.Dry Hole                                 Abandoned                                 

Date

FEB 12 1941 19

S. J. LEWIS Scout