

KANSAS

Form 51-5M-7-40-Palace


Ellsworth.

Section 9 Township 16 Range 10-W

Well No. #2 Boye

Company Aylward Production

NORTH Stoltenberg Pool

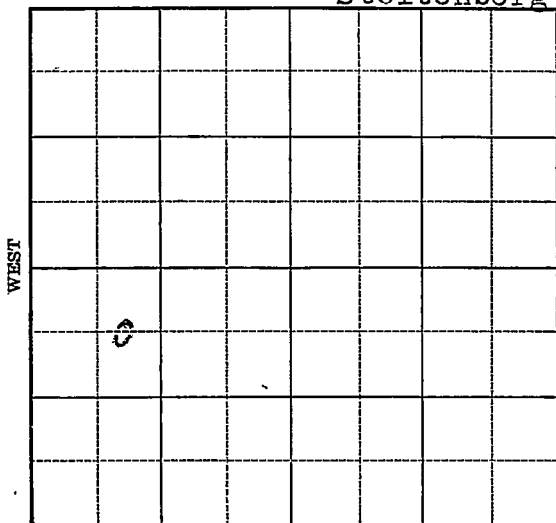

12

SOUTH

Sec. 9 Twp. 16 R. 10-W

Well No. #2 Boye Farm

Aylward Prod. Company

(Stoltenberg)


660 Ft. from N. Line

_____ Ft. from S. Line

_____ Ft. from E. Line

990 Ft. from W. Line

Elev. 1859

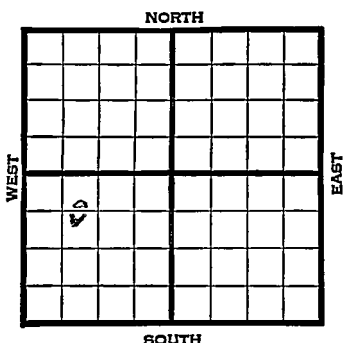

1940	REPORT
10/23	S. H.
10/31	10" - 480' Anhy 640'
	Drlg. 2717'
11/7	Arb. 3337-38' T.D. 5" - 3338'
	RUST.
11/14	"
11/20	Arb. 3335'
	6" - 3336'
	T.D. 3346'
	P.B. 3343'
	Potential 141 bbls., pump.
	44. Gravity
	COMPLETED

Map No. 55 Sec. 9 Twp. 16 R. LOW

Well No. 2 Boye

Aylward Production Company

Contractor

COMPLETED

C E L NW SW

660 Ft. from N. Line

_____ Ft. from S. Line

_____ Ft. from E. Line

990 Ft. from W. Line

STOLTENBERG POOL

SECTION PLAT

.	o		

Location _____

Rig up _____

Drilling and Remarks:

Cr 83335

6" @ 3336

P. 83343

Sum. 141 P.D.

4 1/2 gravity

RECORD

Cased _____ in., _____ ft.

Sand _____

Gas _____

Oil _____

Total Depth 3346

PRODUCTION

1st 24 hrs. Nat. _____

1st 24 hrs. after shot _____

Gas _____ Cu. Ft.

Dry Hole _____

Abandoned _____

Date

NOV 20 1940 19

S. J. LEWIS Scout