KANSAS Ellsworth


FORM 51 5M 4-41 PETROL

Section 9 Township 16 Range 10-W

Well No. #3 Boye

Company Aylward Producting

Stoltenberg Pool

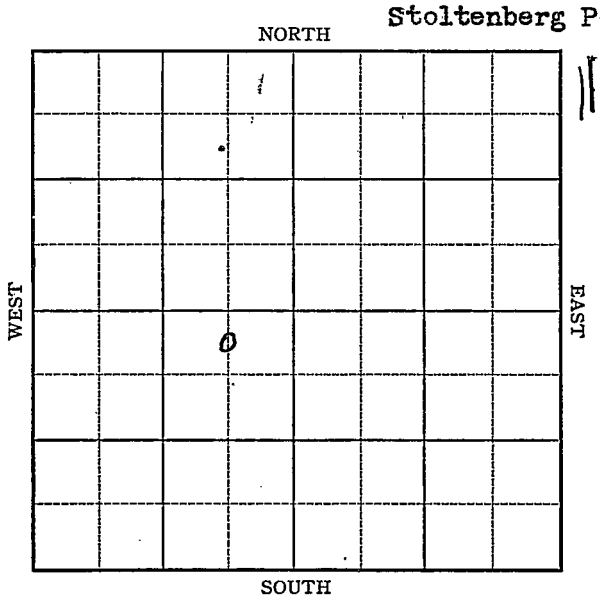

FORM 252-A
5M 10-41 PETROL

KANSAS

Ellsworth

Sec. 9 Twp. 16 R. 10-W

Well No. #3 Boye Farm

Aylward Production Company

(Stoltenberg)


355 Ft. from N. Line

Ft. from S. Line

660 Ft. from E. Line

Ft. from W. Line

Elev. 1823

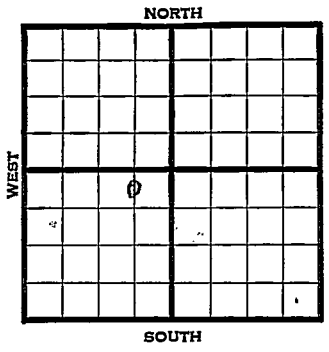

1941	REPORT
12/17	Rotary
12/24	8" - 230' WOC.
12/31	Drlg. 2475'.
1942	
1/8	B.K.C. 3268' Simpson 3284'
	Arb. 3303-05' T.D. 5" - 3303'
	RUST.
1/15	1500' oil, 1000' water 2 hours.
1/22	Pump 70 fluid per hour 4 hours.
	15% water.
1/28	Arb. 3303'
	5" - 3303'
	T.D. 3305'
	Pump 48 oil & 15 water, potential.
	44.2 Gravity
	COMPLETED

Form 26 200 Bks. 5-41 McW. Ellsworth KANSAS

Map No. 55 Sec. 9 Twp. 16 R. 10W

Well No. 3 Boye

Aylward Production Company

Contractor

FIRST REPORT

C N L NE SW

355 Ft. from N. Line


Ft. from S. Line

660 Ft. from E. Line

Ft. from W. Line

STOLTENBERG POOL

SECTION PLAT

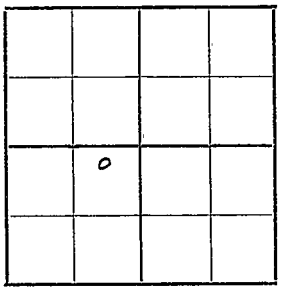

Location

Rig up

Drilling and Remarks:

Rotary

RECORD

Cased in., ft.

Sand

Gas

Oil

Total Depth

PRODUCTION

1st 24 hrs. Nat.

1st 24 hrs. after shot

Gas Cu. Ft.

Dry Hole

Abandoned

Date

DEC 17 1941 19 S. J. LEWIS Scout

Form 26 200 Bks. 5-41 McW. Ellsworth KANSAS

Map No. 55 Sec. 9 Twp. 16 R. 10W

Well No. 3 Boye

Aylward Production Company

COMPLETED Contractor

C NL NE SW


355 Ft. from N. Line

Ft. from S. Line

660 Ft. from E. Line

Ft. from W. Line

SECTION PLAT

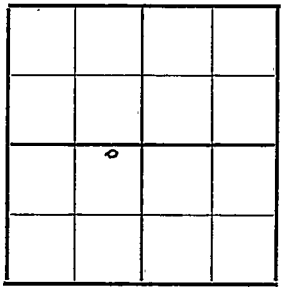

STOLTENBERG POOL

Location

Rig up

Drilling and Remarks:

Ran 3303
5" @ 3303
Pump 48 bbl. 15 Ne Tes
Pot.

44-2/60

RECORD

Cased in., ft.

Sand

Gas

Oil

Total Depth 3305

PRODUCTION

1st 24 hrs. Nat.

1st 24 hrs. after shot

Gas Cu. Ft.

Dry Hole

Abandoned

Date

JAN 2 8 1942 19

S. J. LEWIS Scout