

KANSAS


Ellsworth

FORM 51 5M 4-41 PETROL

Section 9 Township 16 Range 10-W

Well No. #1 Kozieck

Company Phillips Petroleum
(Stoltenberg)

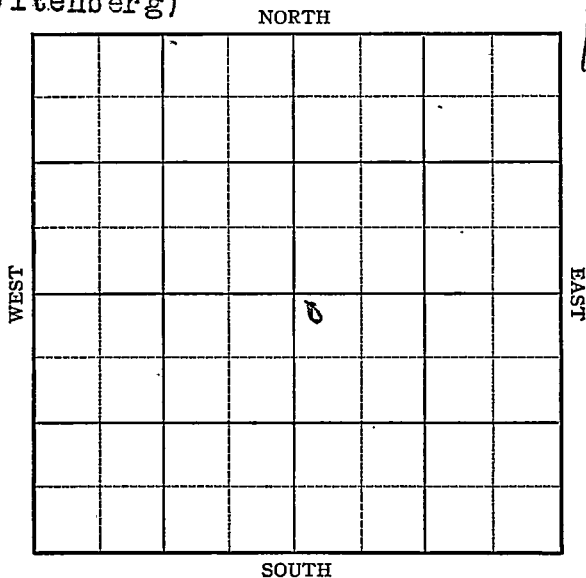


KANSAS

Ellsworth

Sec. 9 Twp. 16 R. 10-WWell No. 1 Kozicek Farm
phillips petroleum Company
(Stoltenberg pool)330 Ft. from N. Line Ft. from S. Line Ft. from E. Line330 Ft. from W. Line

Elev. 1801

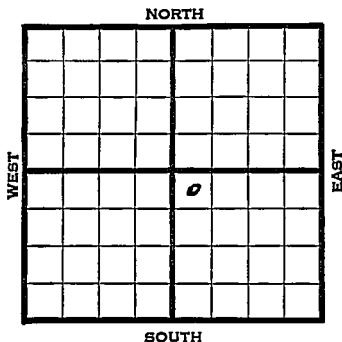

1941

REPORT

8/6 Run 8" 425'

8/15 8" - 418' . . . Drlg. 2600'

8/21 Arb. 3293-96' T.D. 5" - 3293'

RUST.

8/28 T.D. 3309' Swab 11 oil & 119
water in 5 hours.

9/3 Arb. 3293'

5" - 3293'

T.D. 3314½'

Water.

ABANDONED

KANSASMap No. _____ Sec. 9 Twp. 16 R. 10WWell No. 1 Kozicek_____
Phillips Petroleum CompanyFIRST REPORT Contractor _____

NW SE


330 Ft. from N. Line

_____ Ft. from S. Line

_____ Ft. from E. Line

330 Ft. from W. Line

SECTION PLAT

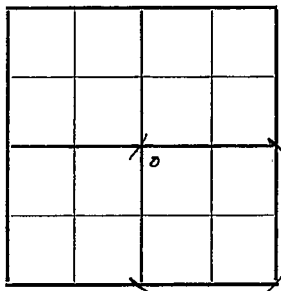

STOLTENBERG POOL

Location _____

Rig up _____

Drilling and Remarks:

Run 8" 425

RECORD

Cased _____ in., _____ ft.

Sand _____

Gas _____

Oil _____

Total Depth _____

PRODUCTION

1st 24 hrs. Nat. _____

1st 24 hrs. after shot _____

Gas _____ Cu. Ft.

Dry Hole _____

Abandoned _____

Date

AUG 6 1941 19 S. J. LEWIS Scout

Map No. _____ Sec. 9 Twp. 16 R. 10WWell No. 1 KozicekPhillips

Company

ABANDONED

Contractor

SECTION PLAT

		0	

NW SE

330 Ft. from N. Line

Ft. from S. Line

Ft. from E. Line

330 Ft. from W. Line

STOLTENBERG POOL

Location _____

Rig up _____

Drilling and Remarks:

*Gr & 3293**5" @ 3293**Water.*

RECORD

Cased _____ in., _____ ft.

Sand _____

Gas _____

Oil _____

Total Depth 3314 1/2

PRODUCTION

1st 24 hrs. Nat. _____

1st 24 hrs. after shot _____

Gas _____ Cu. Ft.

Dry Hole _____

Abandoned _____

Date

SEP 3 1941 19S. J. LEWIS Scout