

Well No. ~~2 LaFont~~ #1 LaFont

Company Derby Oil et al Grant Oil

NORTH Stoltenberg Pool

WEST

EAST

SOUTH

0

KANSAS

Elsworth

Sec. 9 Twp. 16 R. 10-W

Well No. #1 LaFont Farm

Derby Oil et al _____ Company


(Stoltenberg)

660 Ft. from N. Line

Ft. from S. Line

Ft. from E. Line

330 Ft. from W. Line

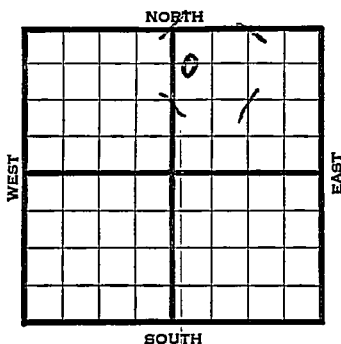

1941

REPORT

8 / 20

S. H.

8 / 28

8" - 620' Dr1g. 2915'

9/3

Arb. 3250'

T.D. 3260

No shows.

ABANDONED

Map No. 55 Sec. 9 Twp. 16 R. 10WWell No. 1 LaFontDerby Oil etal

Company


FIRST REPORT

Contractor

C W L NW NE

660 Ft. from N. Line Ft. from S. Line Ft. from E. Line330 Ft. from W. Line

SECTION PLAT

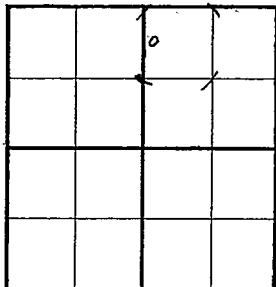

STOLTENBERG POOL

Location Rig up

Drilling and Remarks:

S. H.

RECORD

Cased in., ft.Sand Gas Oil Total Depth

PRODUCTION

1st 24 hrs. Nat. 1st 24 hrs. after shot Gas Cu. Ft.Dry Hole Abandoned

Date

AUG 20 1941 19S. I. LEWIS Scout

Map No. _____ Sec. 9 Twp. 16 R. 10W

Well No. 1 LaFont

Derby Oil etal

Company

ABANDONED

Contractor

C W L NW NE

SECTION PLAT

		0	

660 Ft. from N. Line

_____ Ft. from S. Line

_____ Ft. from E. Line

330 Ft. from W. Line

STOLTENBERG POOL

Location _____

Rig up _____

Drilling and Remarks:

Cr 83250

No show

RECORD

Cased _____ in., _____ ft.

Sand _____

Gas _____

Oil _____

Total Depth 3260

PRODUCTION

1st 24 hrs. Nat. _____

1st 24 hrs. after shot _____

Gas _____ Cu. Ft.

Dry Hole _____

Abandoned _____

Date

SEP 3 1941 19

S. J. LEWIS

Scout

~~Not for sale~~
~~Not for sale~~
O.W.W.O.

County Ellsworth Elev. _____
 Sec. 9 Twp. 16 Rge. 10W
 Company Grant Oil Co.
 Farm Name Lafon No. 1

TOPS	DEPTH	LOG	DATUM
Anh.			
Tp.			
H.			
Tr.			
Dg.			
B.L.			
L.			
K.C.			
B.K.C.			
Ce.			
C.			
M.			
M.			
K.			
Mz.			
Mq.			
V.			
S.			
S.			
A.			
R.			
Pf.			
G.			
T.D.			

Loc. in Sec. _____

W/2 NW NE


O.W.W.O.**O.W.W.O.**

Geol. _____

Contr. _____

B-B tools

Pool _____

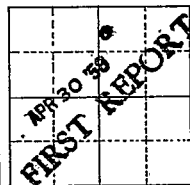Stoltenberg

Date Comm. _____

Location _____

Co.

Lse.

No.

Sec.

T.

R.

Co. ~~Facet~~ ~~011110~~

S-513.8

County Ellsworth Elev. 17520 ft
Sec. 9 Twp. 16 Rge. 10W
Company Grant Oil Co.
Farm Name Lafont No. 1

TOPS	DEPTH	LOG	DATUM
Anh.			
Tp.			
H.			
Tr.			
Dg.			
B.L.			
L.	2901		
K.C.			
B.K.C.			
Ce.			
C.			
M.			
M.			
K.			
Mz.			
Mq.			
V.			
S.			
S.			
A.	3250		
R.			
Pf.			
G.			
OTD.	3260		

Loc. in Sec.

W/2 NW NE

Q.W.W.O.

Geo. O. W. W. O.

Contr..

B-B tools

Pool

Stoltenberg

ABANDONED

MAY 21 '58

Date Comm.

8"620

Location MAY 7 '58 ~~Ø 1941~~ RTP 3273

15" 3273 MAY 14 '58 MAY 21 '58 CO 3270

12/3263-66 FU 2300' SW 25"

PB 3259 12/ 3253-56 FU 4305W

mt.

D-6A