


Section 9 Township 16 Range 10W

Well No. #1 Kozeisk

Company Rocket Drlg. Inc.

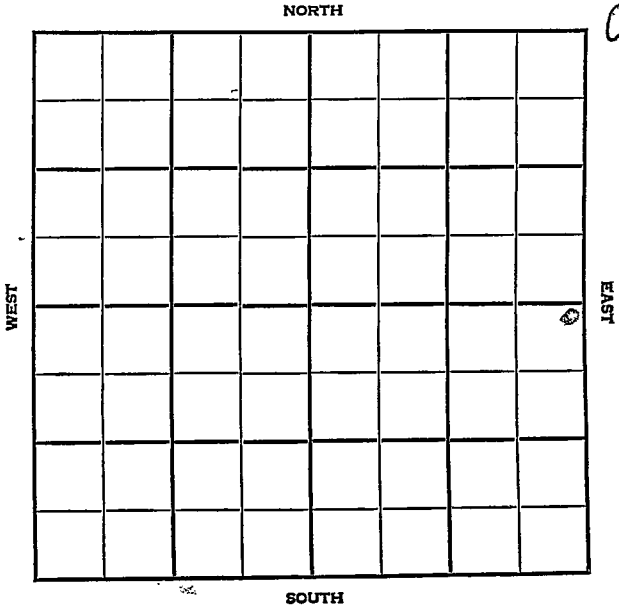

Ellsworth


KANSAS

SEC. 9	TWP. 16	R. 10W
-----------	------------	-----------

WELL NO. #1- Kozeisk FARM

COMPANY Rocket Drlg. Inc.

CONTRACTOR

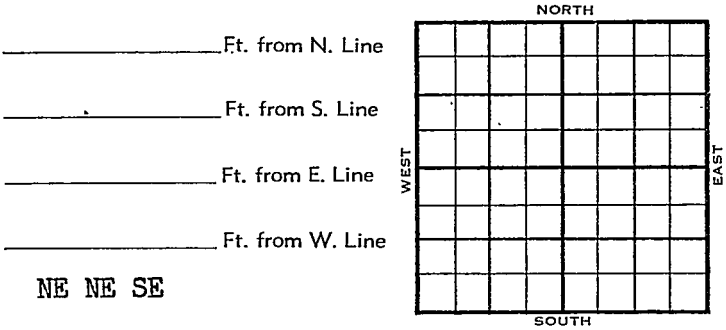

1955	ELEVATION 1833	REPORT
------	-------------------	--------

6/1  
 Comm. 5-16-55  
 8" @284 DST 3323-99 open 1 hr.  
 Rec. 45' mud 10' socm 760# DST 3398-3402, open 1 hr. Rec. 80' wcm SSQ 1100", DST 3401-07 open 1 hr. Rec. 10' mud 906# D&A

	Depth	Datum
H.	2880	1047
Bl.	2984	1151
L.	3005	1172
KC	3325	1492
C. Ch.	3333	1500
A.	3396	1563
TD.	3426	

FIRST REPORT



**ABANDONED**

County Ellsworth Elev. 1833  
 Sec. 9 Twp. 16 Rge. 10W  
 Company Rocket Drlg. Inc.  
 Farm Name Kozeisk No. 1

TOPS	DEPTH	LOG	DATUM
Anh.			
Tr.	<u>2880</u>		<u>1097</u>
Dg.			
Bl.	<u>2984</u>		<u>1151</u>
L.	<u>3005</u>		<u>1172</u>
K.C.	<u>3325</u>		<u>1492</u>
B.K.C.			
Ce.			
C. <u>Ch.</u>	<u>3333</u>		<u>1500</u>
M.			
M.			
K.			
Mz.			
Me.			
V.			
S.			
S.			
A	<u>3396</u>		<u>1563</u>
R.			
PE.			
G.			
T.D.	<u>3426</u>		

Loc. in Sec. NE NE SE

Geol. \_\_\_\_\_

Contr. \_\_\_\_\_

Pool \_\_\_\_\_

Stoltenberg

**FIRST REPORT**  
**ABANDONED**

Date Comm. 5-16-55

JUN 1 1955

8" @ 284 DST 3323-99 open 1 hr.

Rec. 45' mud 10' socm 760#

DST 3398-3402 open 1 hr. Rec. 80' wcm

SSO 1100" DST 3401-07 open 1 hr.

Rec. 10' mud 906#

D & A