


Section 9 Township 16 Range 10W

Well No. 1 Lank

Company Derby Oil etal

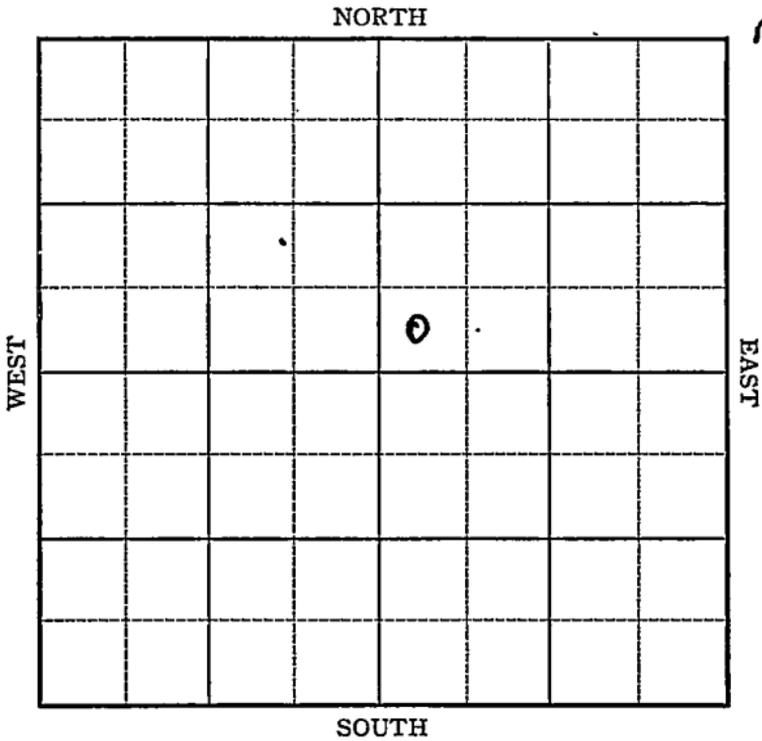

Sec. 9 Twp. 16 R. 10-W

Well No. #1 Lan k Farm


Derby Oil et al Company
(Stoltenberg)

_____ Ft. from N. Line

330 Ft. from S. Line

_____ Ft. from E. Line

330 Ft. from W. Line

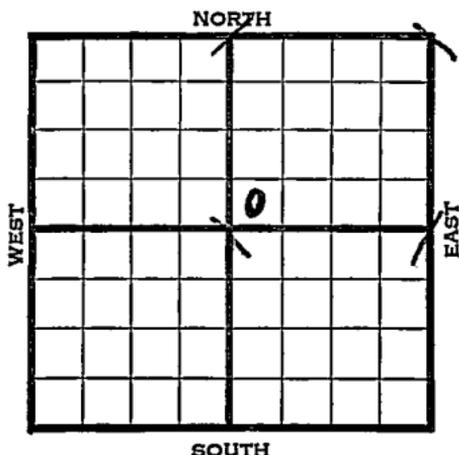

Elev. 1784

REPORT

1941

6/18 Run 8" - 630'

6/26 8" - 620' Drlg. 2792'

7/3 Lans. 2927' Arb. 3261-64' T.D.
4" - 3262'

7/10 1000 acid. Swab 77 oil in 1 hr.

7/16 Arb. 3261'

4" - 3262'

T.D. 3267'

1000 acid.

Depthograph potential 18,190 bbl

Maximum 3000 bbls.

44. Gravity

COMPLETED

Map No. _____ Sec. 9 Twp. 16 R. 10W

Well No. 1 Lank

Derby Oil etal Company

~~FIRST REPORT~~ Contractor

SW NE


_____ Ft. from N. Line

330 Ft. from S. Line

_____ Ft. from E. Line

330 Ft. from W. Line

SECTION PLAT

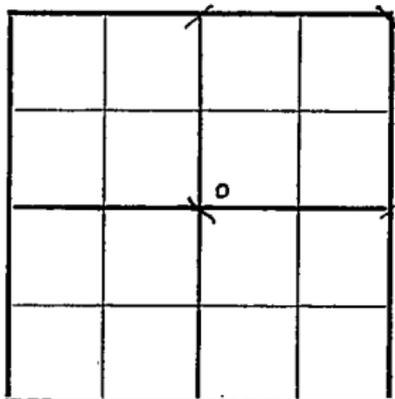

STOLTENBERG POOL

Location _____

Rig up _____

Drilling and Remarks:

Run 8" 630

RECORD

Cased _____ in., _____ ft.

Sand _____

Gas _____

Oil _____

Total Depth _____

PRODUCTION

1st 24 hrs. Nat. _____

1st 24 hrs. after shot _____

Gas _____ Cu. Ft.

Dry Hole _____

Abandoned _____

Date

JUN 18 1941 19

S. J. LEWIS Scout

Map No. 55 Sec. 9 Twp. 16 R. 10W

Well No. 1 Lank

Derby etal Company

Contractor

COMPLETED

SECTION PLAT

SW NE

 Ft. from N. Line

330 Ft. from S. Line

 Ft. from E. Line

330 Ft. from W. Line

		6	

STOLTENBERG POOL

Location

Rig up

Drilling and Remarks:

Cor 83261
4" @ 3262
1000 aced
Depth 8 18790
Map 3000
440 gr

RECORD

Cased in., ft.

Sand

Gas

Oil

Total Depth 3267

PRODUCTION

1st 24 hrs. Nat.

1st 24 hrs. after shot

Gas Cu. Ft.

Dry Hole

Abandoned

Date

JUL 16 1941 19 S. J. LEWIS Scout