

# KANSAS

Form 51-5M-7-39-Palace


## Ellsworth

Section 9 Township 16 Range 10-W

Well No. #1 Skalicky

Company Magnolia

NORTH **Stoltenberg Pool**

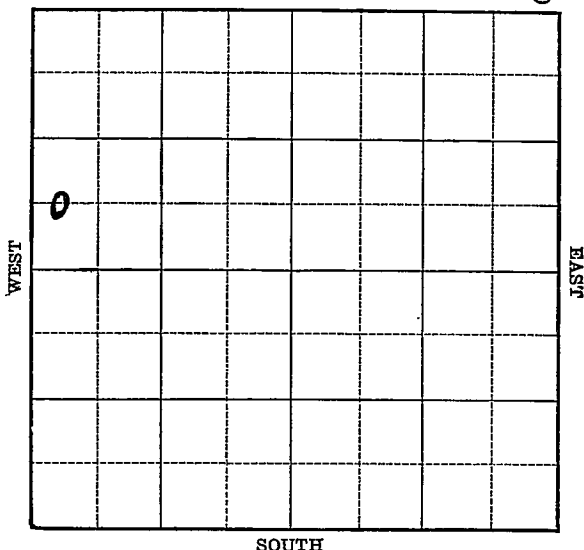

Sec. 9 Twp. 16 R. 10-W

Well No. #1 Skalicky Farm

Magnolia Company

(Stoltenberg)


\_\_\_\_\_ Ft. from N. Line

660 Ft. from S. Line

\_\_\_\_\_ Ft. from E. Line

330 Ft. from W. Line

**Elev. 1845**

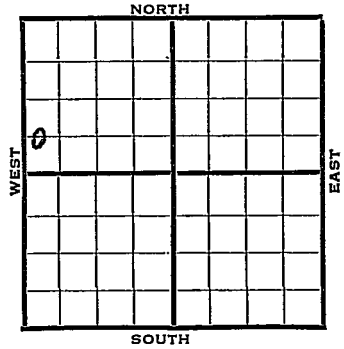

1940	REPORT
3/20	Rotary.
3/28	Rigging up.
4/4	10" - 365' Drlg. 1335'
4/12	Drlg. 2812'
4/18	Lans. 2990' Arb. 3293'
	5" - 3293' T.D. 3297' RUST.
4/25	T.D. 3303' Swab 63 bbls. per hour. 2000' off bottom.
5/1	Arb. 3293'
	5" - 3293'
	T.D. 3303'
	Depthograph potential 9690 bbls.
	Maximum 3000 bbls.
	<b>COMPLETED</b>

Ellsworth **KANSAS**Map No. 55 Sec. 9 Twp. 16 R. 10WWell No. 1 SkalickyMagnolia

Company

Contractor

**FIRST REPORT****C W L SW NW****SECTION PLAT**


         Ft. from N. Line660 Ft. from S. Line         Ft. from E. Line330 Ft. from W. Line**STOLTENBERG POOL**Location                                 Rig up                                 

Drilling and Remarks:

**Rotary****RECORD**Cased          in.,          ft.Sand                                 Gas                                 Oil                                 Total Depth                         **PRODUCTION**1st 24 hrs. Nat.                         1st 24 hrs. after shot                         Gas                                  Cu. Ft.Dry Hole                                 Abandoned                                 

Date

MAR 20 1940

19

S. J. LEWIS

Scout

Form 26—200 Bks.—1-40—Palace Ellsworth

Map No. 55 Sec. 9 Twp. 16 R. 10W

Well No. 1 Skalicky

Magnolia Company

COMPLETED Contractor

C W L SW NW

SECTION PLAT


\_\_\_\_\_ Ft. from N. Line

660 Ft. from S. Line

\_\_\_\_\_ Ft. from E. Line

330 Ft. from W. Line

STOLTENBERG POOL

Location \_\_\_\_\_

Rig up \_\_\_\_\_

Drilling and Remarks:

*at 3293*

*5" C 3293*

*Geographical Plot  
9690*

*Maximum 3000*

RECORD

Cased \_\_\_\_\_ in., \_\_\_\_\_ ft.

Sand \_\_\_\_\_

Gas \_\_\_\_\_

Oil \_\_\_\_\_

Total Depth 3303

PRODUCTION

1st 24 hrs. Nat. \_\_\_\_\_

1st 24 hrs. after shot \_\_\_\_\_

Gas \_\_\_\_\_ Cu. Ft.

Dry Hole \_\_\_\_\_

Abandoned \_\_\_\_\_

Date

MAY 1 1940 19

S. J. LEWIS Scout