


Section 9 Township 16 Range 10-w

Well No. #1 Skalicky

Company L. W. Prunty

NORTH Stoltenberg Pool

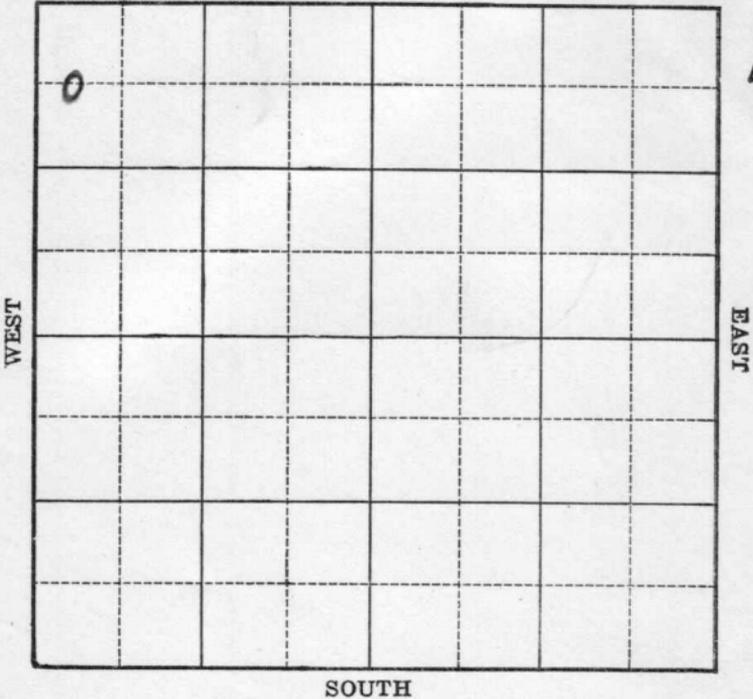

Sec. 9 Twp. 16 R. 10-W

Well No. #1 Skalicky Farm

L. W. Prunty Company

(Stoltenberg)


660 Ft. from N. Line

_____ Ft. from S. Line

_____ Ft. from E. Line

330 Ft. from W. Line

Elev. 1786

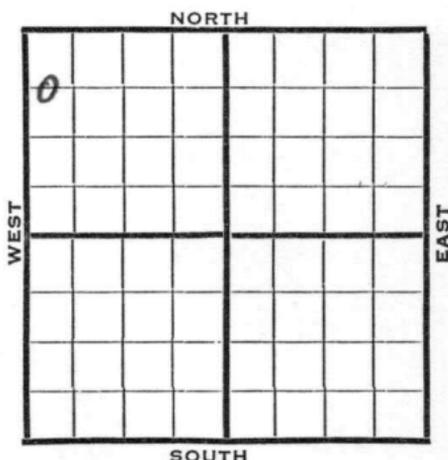

1940	REPORT
4/24	Ponds.
5/2	10" - 343' WOC.
5/9	Drlg. 2295'
5/16	Arb. 3249' ^{3249'} -60' T.D. 5" - 3251'
	RUST.
5/23	"
5/29	Arb. 3249' (Corrected)
	5" - 3249' T.D. 3272'
	1000 acid. Swab 150 bbls. in 3 hours.
6/5	Arb. 3249'
	5" - 3249'
	T.D. 3272'
	7000 acid.
	Depthograph potential 3061 bbls.
	Maximum 3000 bbls.
	COMPLETED

Ellsworth

Map No. 55 Sec. 9 Twp. 16 R. 10W

Well No. 1 Skalicky


L. W. Prunty Company

Contractor

FIRST REPORT

SECTION PLAT

660 C W L NW NW
Ft. from N. Line

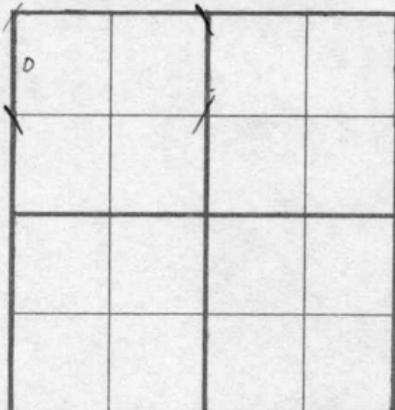

_____ Ft. from S. Line

_____ Ft. from E. Line

330 Ft. from W. Line

STOLTENBERG POOL

Location _____

Rig up _____

Drilling and Remarks:

Ponds

RECORD

Cased _____ in., _____ ft.

Sand _____

Gas _____

Oil _____

Total Depth _____

PRODUCTION

1st 24 hrs. Nat. _____

1st 24 hrs. after shot _____

Gas _____ Cu. Ft.

Dry Hole _____

Abandoned _____

Date

APR 24 1940 19

S. J. LEWIS Scout

Map No. 55 Sec. 9 Twp. 16 R. 10W

Well No. 1 Skalicky

L. W. Prunty Company

Contractor

COMPLETED

C W L NW NW

660 Ft. from N. Line

_____ Ft. from S. Line

_____ Ft. from E. Line

330 Ft. from W. Line

SECTION PLAT

0			

STOLTENBERG POOL

Location _____

Rig up _____

Drilling and Remarks:

Art 3249
5" C3249
7000 acid
Dyeograph 28
3061

May 3000

RECORD

Cased _____ in., _____ ft.

Sand _____

Gas _____

Oil _____

Total Depth 3222

PRODUCTION

1st 24 hrs. Nat. _____

1st 24 hrs. after shot _____

Gas _____ Cu. Ft.

Dry Hole _____

Abandoned _____

Date

JUN 5 1940 19

S. J. LEWIS Scout