


Section 2 Township 25 Range 5E

Well No. #10 Bond

Company Geo. Braum

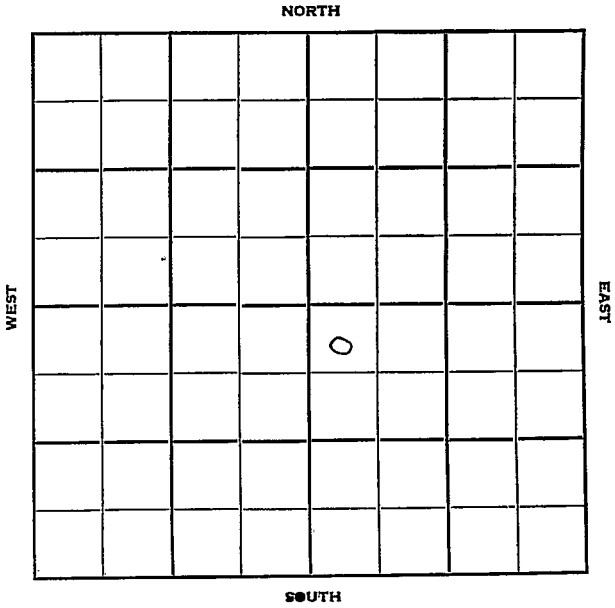

Sec. 2 Twp. 25 R. 5E

Well No. #10 Bond Farm

Geo. Braum Company

Morrison Drlg. Contractor


330 Ft. from N. Line

Ft. from S. Line

Ft. from E. Line

330 Ft. from W. Line

NW NW SE

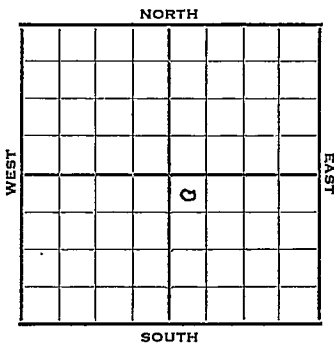

1952

Elev. 1375 REPORT

7/30

MIM

9/4

Spud 7-28-52

Oil Well TD 2611

8" @ 67

Peru 2264 Burgess 2396

Viola 2584 Simp 2598

TD 2611 5" @ 2611

24/2582-88 HFW 20/2396-2400

27/2263-67 2274-80

S/48 bo 336 bwpd Comp. 20 bopd
lot of wtr.

COMPLETED

