

Butler


KANSAS

SECTION 2 TOWNSHIP 25S RANGE 5E

WELL NO. #11 Bond

COMPANY R.W. Musgrove

NORTH ^{N/2}
~~NW~~ NW SE

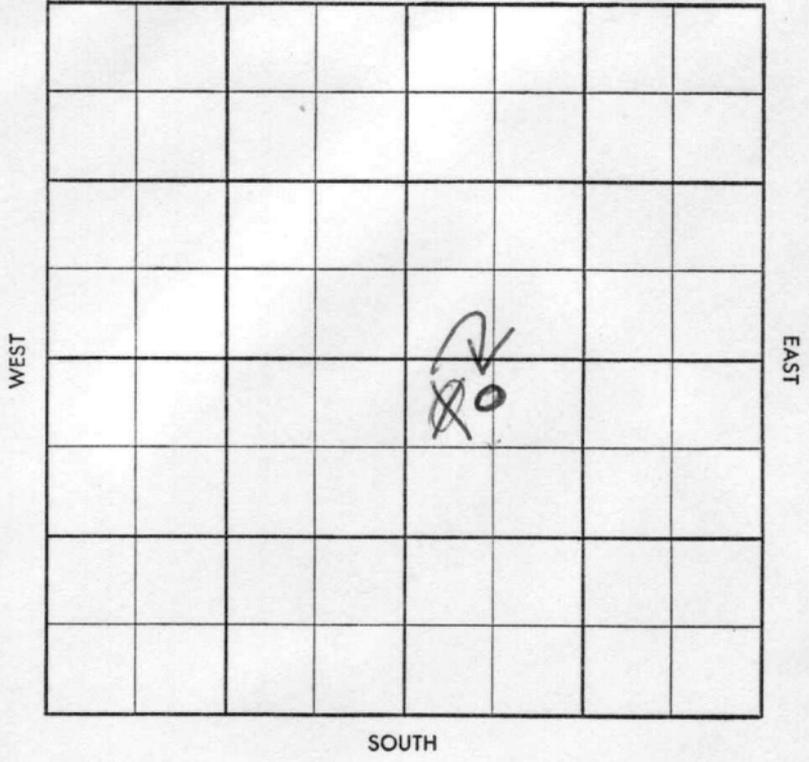


29

County Butler Elev. _____
 Sec. 2 Twp. 25 Rge. 5E
 Company R. W. Musgrove
 Farm Name Bond No. 11

TOPS	DEPTH	LOG	DATUM
Anh.			
Tp.			
H.			
Tr.			
Dg.			
B.L.			
L.			
K.C.			
B.K.C.			
Ce.			
C.			
M.			
M.			
K.			
Mz.			
Mq.			
V.			
S.			
S.			
A.			
R.			
Pf.			
G.			
T.D.			

Loc. in Sec. _____
NW NW SE
 Geol. _____
 Contr. _____ #4
White & Ellis
 Pool _____
Eldorado

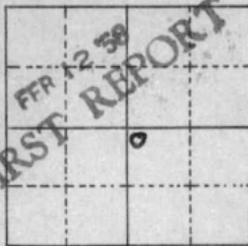

Date Comm. _____
Location. Setting surf with spudder.

Co.
 Lsq
 No.
 Sec.
 T.
 R.

~~CORRECTION~~

~~29~~

S-513-B

County Butler Elev. 13670
 Sec. 2 Twp. 25 Rge. 5E
 Company R. W. Musgrove
 Farm Name Bond No. 11

TOPS	DEPTH	LOG	DATUM	Loc. in Sec.
Anh.				<div style="border: 1px solid black; border-radius: 50%; padding: 5px;"> <p>N/2 NW NW SE 2440' FSL - 2250' FSL OF 1530</p> </div>
Tp.				
H.				
Tr.				
Dg.				
B.L.				
L.				
K.C.	<u>2004</u>			
B.K.C.	<u>2171</u>			
Ce.	<u>Peru</u> <u>2250</u>			
C.				Geol.
M.				Contr. <u>#4</u>
M.				Pool
K.				<u>ElDorado</u>
Mz.				<div style="border: 1px solid black; padding: 5px;"> <p>COMPLETE</p> <p style="text-align: center;">✓ RC</p> <p style="text-align: right;">MAR 12 '58</p> </div>
Mq.				
V.				
S.				
S.				
A.				
R.				
Pf.				
G.				
T.D.	<u>2261</u>			

Date Comm. 2-11-58 10"205
 Location. Setting surf with spudder.

FEB 19 '58 7" 2259 FEB 10 '58 MAR 5 '58 MAR 12 '58
DD 2266 Frac P 1530
+ 70% 24 hrs

⊕

Co. No. Sec. T. R.