

KANSAS


FORM 51 5M BR1X

Butler County

Section 2 Township 25 Range 5E

Well No. #2 Cameron (A) (KGS DRL)

Company E. B. Shawner

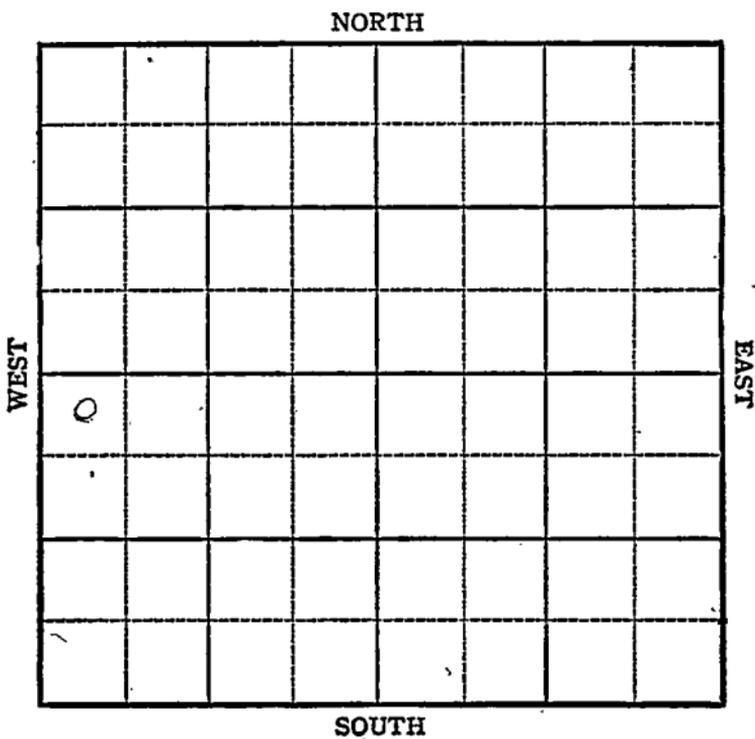

Sec. 2 Twp. 25 R. 5E

Well No. 2 Cameron (A) (KGS DRL) Farm

E. B. Shawner Company


Miscellaneous

330 Ft. from N. Line

 Ft. from S. Line

 Ft. from E. Line

330 Ft. from W. Line

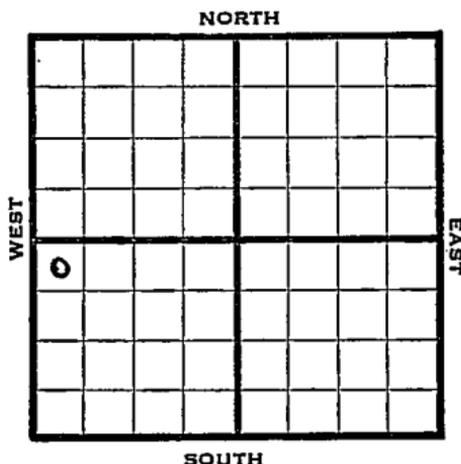

1944

REPORT

7/5	10" - 3 4'		
	1027' Drlg.		
7/12	7" @ 2160	TD 2166	RUST
7/19	Pern 2168		
	TD 2209		
	120 qts CO		
7/26	Pern. 2168		
	7" @ 2160		
	140 qts. 2171-2209		
	Pump 50 Pot.		
	Grav. 37.		
	TD 2209		

COMPLETED

Pool Name Miscellaneous

Map No. KANSAS Sec. 2 Twp. 25 R. 5E

Well No. 2 Cameron (A) (KGS DRL)

E. B. Shawner Company

FIRST REPORT Contractor

NW SW

SECTION PLAT

330 Ft. from N. Line

_____ Ft. from S. Line

_____ Ft. from E. Line

330 Ft. from W. Line

o			

Butler County

Location _____

Rig up _____

Drilling and Remarks:

10" - 34'

1027'

RECORD

Cased _____ in., _____ ft.

Sand _____

Gas _____

Oil _____

Total Depth _____

PRODUCTION

1st 24 hrs. Nat. _____

1st 24 hrs. after shot _____

Gas _____ Cu. Ft.

Dry Hole _____

Abandoned _____

Date

JUL 5 1944 19

S. J. LEWIS Scout

Pool Name Miscellaneous

KANSAS

Map No. 79 Sec. 2 Twp. 25 R. 5E

Well No. 2 Cameron (A) (KGS DRL)

E. B. Shaw ver _____ Company

COMPLETED Contractor

NW SW

SECTION PLAT

330 Ft. from N. Line

_____ Ft. from S. Line

_____ Ft. from E. Line

330 Ft. from W. Line

6			

Butler County

RECORD

Location _____

Cased _____ in., _____ ft.

Rig up _____

Sand _____

Drilling and Remarks:

Gas _____

Oil _____

Total Depth 2209

Peru 2168
7" @ 2168
1409 to 2171 - 2209
Pump 50 BHP
37° S

PRODUCTION

1st 24 hrs. Nat. _____

1st 24 hrs. after shot _____

Gas _____ Cu. Ft.

Dry Hole _____

Abandoned _____

Date

JUL 26 1944 19

S. J. LEWIS Scout