

KANSAS


Ellsworth

Form 51—5M—7-40—Palace

Section 9 Township 16 Range 10-W

Well No. #2 Skalicky

Company Magnolia

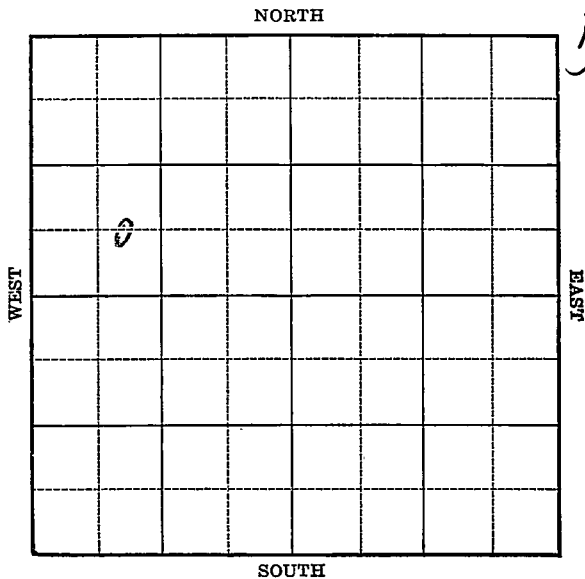


Sec. 9 Twp. 16 R. 10-WWell No. #2 Skalicky FarmMagnolia Company

(Stoltenberg)

 Ft. from N. Line660 Ft. from S. Line Ft. from E. Line990 Ft. from W. Line

Elev. 1828

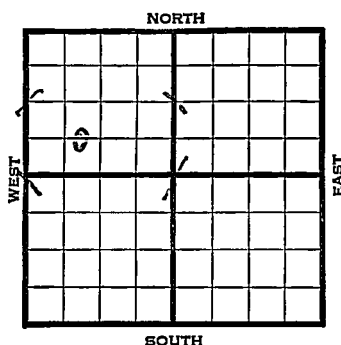

1940	REPORT
9/11	Derrick.
9/19	"
9/26	"
10/3	10" - 358' WOC.
10/10	Drilg. 2620'
10/17	Lans. 2965' Arb. 3287-90' TD
	5" - 3288' RUST.
10/24	T.D. 3298' Swab 37 bbls. 3 hrs.
	6000 acid.
10/30	Arb. 3287'
	5" - 3288'
	T.D. 3298'
	6000 acid.
	Echometer potential 22,792 bbls.
	Maximum 3000 bbls.
	COMPLETED

Map No. 55 Sec. 9 Twp. 16 R. 10WWell No. 2 SkalickyMagnolia Company

Contractor


FIRST REPORT

C E L SW NW

 Ft. from N. Line660 Ft. from S. Line Ft. from E. Line990 Ft. from W. Line

Stoltenberg Pool

SECTION PLAT

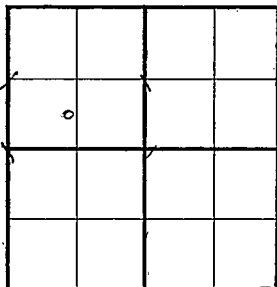Location Rig up

Drilling and Remarks:

Derrick

RECORD

Cased in., ft.Sand Gas Oil Total Depth

PRODUCTION

1st 24 hrs. Nat. 1st 24 hrs. after shot Gas Cu. Ft.Dry Hole Abandoned

Date

SEP 11 1940 19S. J. LEWIS Scout

Map No. 53 Sec. 9 Twp. 16 R. 10WWell No. 2 SkalickyMagnolia Company

Contractor

COMPLETED

C E L S W N W

 Ft. from N. Line660 Ft. from S. Line Ft. from E. Line990 Ft. from W. Line

STOLTENBERG POOL

SECTION PLAT

Location Rig up

Drilling and Remarks:

*Ce 82287**5" @ 3288**6000 acid**Echr P 822792.**Flow 3000***RECORD**Cased in., ft.Sand Gas Oil Total Depth 3298 **PRODUCTION**1st 24 hrs. Nat. 1st 24 hrs. after shot Gas Cu. Ft.Dry Hole Abandoned

Date

OCT 30 1940 19S. J. LEWIS Scout