

# KANSAS

FORM 51 5M 4-41 PETROL

Ellsworth


Section 9 Township 16 Range 10-W

Well No. 3 Skalicky

Company Magnolia

Stoltenberger pool

NORTH

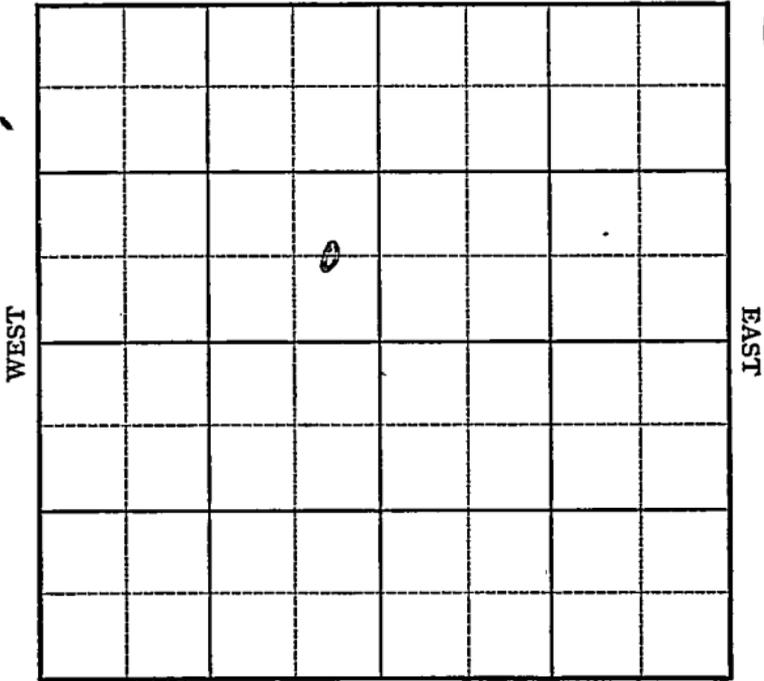

SOUTH

Sec. 9 Twp. 16 R. 10-W

Well No. #3 Skalicky Farm

Magnolia Company

(Stoltenberger)


         Ft. from N. Line

660 Ft. from S. Line

330 Ft. from E. Line

         Ft. from W. Line

**Elev. 1806**

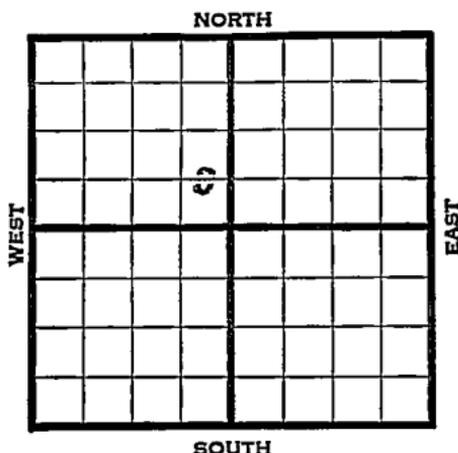

1941	REPORT
10/8	Location
10/16	"
10/23	Rotary.
10/30	10" - 298' WOC.
11/6	Drlg. 2510'
11/13	Arb. 3276-79' T.D. 5" - 3277'
	RUST.
11/19	Arb. 3276'
	5" - 3277'
	T.D. 3286'
	2000 acid.
	Echometer potential 33,450 bbls.
	Maximum 3000 bbls.
	44. Gravity
	<b>COMPLETED</b>

Ellsworth

KANSAS

Map No. H-55 Sec. 9 Twp. 16 R. 10WWell No. 3 SkalickyMagnolia

Company

**FIRST REPORT**

Contractor

C EL SE NW

\_\_\_\_\_ Ft. from N. Line

660 Ft. from S. Line330 Ft. from E. Line

\_\_\_\_\_ Ft. from W. Line

## SECTION PLAT

	o		

STOLTENBERGER POOL

Location \_\_\_\_\_

Rig up \_\_\_\_\_

Drilling and Remarks:

## RECORD

Cased \_\_\_\_\_ in., \_\_\_\_\_ ft.

Sand \_\_\_\_\_

Gas \_\_\_\_\_

Oil \_\_\_\_\_

Total Depth \_\_\_\_\_

## PRODUCTION

1st 24 hrs. Nat. \_\_\_\_\_

1st 24 hrs. after shot \_\_\_\_\_

Gas \_\_\_\_\_ Cu. Ft.

Dry Hole \_\_\_\_\_

Abandoned? \_\_\_\_\_

Date

OCT 8 1941 19

S. J. LEWIS

Scout

Map No. K-55 Sec. 9 Twp. 16 R. 10W

Well No. 3 Skalicky

Magnolia Company

**COMPLETED** Contractor

C E L S E N W

         Ft. from N. Line

660 Ft. from S. Line

330 Ft. from E. Line

         Ft. from W. Line

**SECTION PLAT**


**STOLTENBERG POOL**

Location                                 

Rig up                                 

Drilling and Remarks:

*Cor Y3276*  
*5" @ 3277*  
*2000 @ oil*  
*Ech P<sub>2</sub> Y33450*  
*May 3000*  
*44 @ Gr*

**RECORD**

Cased          in.,          ft.

Sand                                 

Gas                                 

Oil                                 

Total Depth 3288

**PRODUCTION**

1st 24 hrs. Nat.                                 

1st 24 hrs. after shot                                 

Gas                                  Cu. Ft.

Dry Hole                                 

Abandoned                                 

Date

NOV 19 1941 19

**S. J. LEWIS**

Scout