


Ellsworth, KANSAS

Section 9 Township 16 Range 10-W

Well No. #3 Skalicky

Company L. W. Prunty

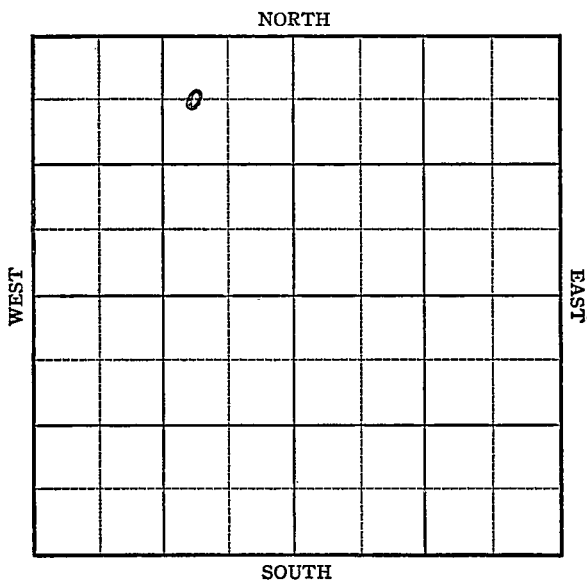

3

Map No. 11-55 Sec. 9 Twp. 16 R. 10WWell No. 3 SkalickyL. W. Prunty Company**FIRST REPORT**

Contractor

C WL NE NW

SECTION PLAT

	0		

660 Ft. from N. Line Ft. from S. Line990 Ft. from E. Line Ft. from W. Line**STOLTENBERG POOL**Location Rig up

Drilling and Remarks:

Derrick

RECORDCased in., ft.Sand Gas Oil Total Depth **PRODUCTION**1st 24 hrs. Nat. 1st 24 hrs. after shot Gas Cu. Ft.Dry Hole Abandoned

Date

NOV 19 1941 19 S. J. LEWIS Scout

Map No. 55 Sec. 9 Twp. 16 R. 10W

Well No. 3 Skalicky

L. W. Prunty Company

ABANDONED Contractor

C WL NE NW

SECTION PLAT

	0		

660 Ft. from N. Line

 Ft. from S. Line

990 Ft. from E. Line

 Ft. from W. Line

STOLTENBERG POOL

Location

Rig up

Drilling and Remarks:

Cr 83302

Water

RECORD

Cased in., ft.

Sand

Gas

Oil

Total Depth 3300

PRODUCTION

1st 24 hrs. Nat.

1st 24 hrs. after shot

Gas Cu. Ft.

Dry Hole

Abandoned

Date

DEC 10 1941 19 S. J. LEWIS Scout