


Section 10 Township 16 Range 10W

Well No. 2 Funk

Company Houston Inv. Co.

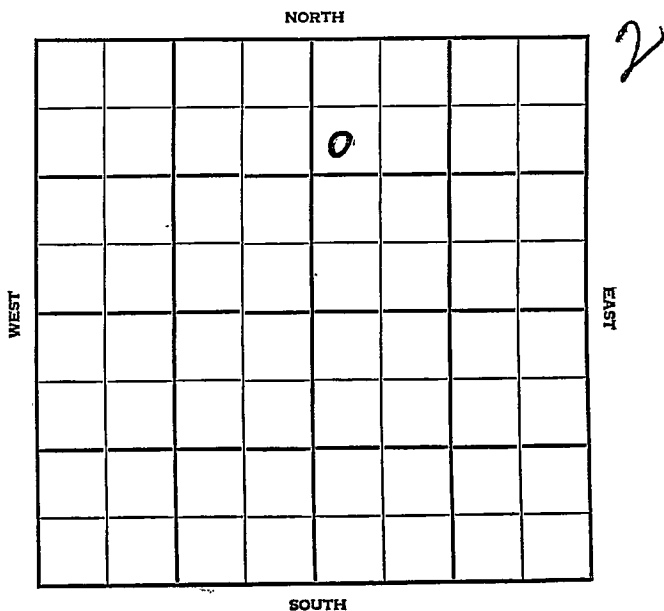

Ellsworth

KANSAS

SEC.	TWP.	R.
10	16	10W

WELL NO.

2 Funk

FARM

COMPANY

Houston Inv. Co.

CONTRACTOR

K &amp; E

Progress


\_\_\_\_\_ Ft. from N. Line

\_\_\_\_\_ Ft. from S. Line

\_\_\_\_\_ Ft. from E. Line

\_\_\_\_\_ Ft. from W. Line

SW NW NE

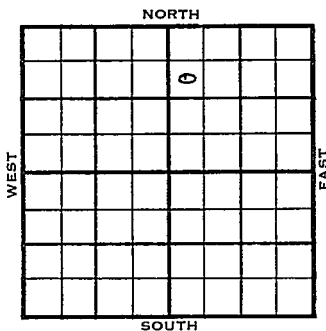

	ELEVATION	REPORT
1955	1871 RB 1868	DF
6/29	Comm 6-23-55 Anh 662 8" @ 366/185 Drlg 2422	
8/10	Comm 6-23-55 Anh 662 Tp 2559 H 2892 Tr 2911 Dg 2921 Bl 2996 L 3014 BKC 3284 C Sh 3331 A 3407 TD 3415 8" @ 366/185 5 1/2" @ 3409/100 CO to 3415 3 1/2 boph DD 3416 250 A S/10 boph 4 hr. Comp 280 bopd 5% wtr.	

COMPLETED

County Ellsworth Elev. \_\_\_\_\_  
 Sec. 10 Twp. 16 Rge. 10W  
 Company Houston Inv. Co.  
 Farm Name Funk No. 2

TOPS	DEPTH	LOG	DATUM
Anh.	662		
Tp.			
H.			
Tr.			
Dg.			
Bl.			
L.			
K.C.			
B.K.C.			
Ce.			
C.			
M.			
M.			
K.			
Mz.			
Me.			
V.			
S.			
S.			
A			
R.			
Pe.			
G.			
T.D.			

Loc. in Sec. SW NW NE

Geol. \_\_\_\_\_

Contr. \_\_\_\_\_

K & E

Pool'

Progress

		0
FIRST REPORT		
JUN 29 '55		

Date Comm. 6-23-55

8" @ 366/185 drlg. 2422

Co.  
Lse.  
No.  
Sec.  
T.  
R.

1877 RB  
1868 DF

County Ellsworth Elev. 1868 DF Co.       
 Sec. 10 Twp. 16 Rge. 10W  
 Company Houston Inv. Co.  
 FarmName Funk No. 2

TOPS	DEPTH	LOG	DATUM
Anh.	662		
Tp.	2559		691
H.	2892		1024
Tr.	2911		1045
Dg.	2921		1053
Bl.	2996		1128
L.	3014		1146
K.C.			
B.K.C.	3284		1416
Ce.			
C. <i>sh</i>	3331		1463
M.			
M.			
K.			
Mz.			
Me.			
V.			
S.			
S.			
A.	3407		1539
R.			
PE.			
G.			
T.D.	3415		

Loc. in Sec. SW NW NE  
 Geol.       
 Contr.       
K & E Drlg.

Pool Progress

AUG. 10 1955		
<b>COMPLETE</b>		

Date Comm. 6-23-55  
8" @ 366/185 5 1/2" @ 3409/100 CO to 3415  
3 1/2 boph DD 3176 250 A S/ 10 boph  
1 hr. Comp. 280 bopd 5% wtr.

Co.       
 Lse.       
 No.       
 Sec.       
 T.       
 R.