

KANSAS

Ellsworth


Form 51-5M-7-40-Palace

Section 9 Township 16 Range 10-W

Well No. #2 Skalicky

Company Prunty

NORTH Stoltenberg Pool

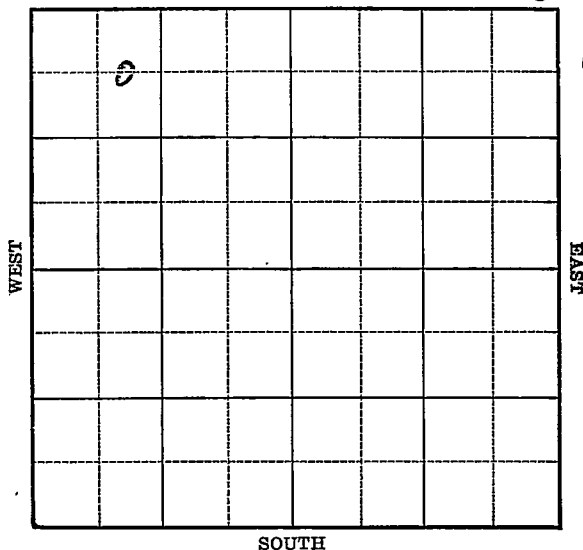

1941

1/15

Arb. 3275'

6" - 3276'

T.D. 3283'

Depthograph potential 7904 bbls.

Maximum 3000 bbls.

44. Gravity

COMPLETED

Map No. 55 Sec. 9 Twp. 16 R. 10WWell No. 2 Skalicky

Prunty

Company

Contractor

FIRST REPORT

C E L NW NW

660 Ft. from N. Line

Ft. from S. Line

Ft. from E. Line

990 Ft. from W. Line**SECTION PLAT**

o			

STOLTENBERG POOL

Location

Rig up

Drilling and Remarks:

Derrick

RECORD

Cased _____ in., _____ ft.

Sand _____

Gas _____

Oil _____

Total Depth _____

PRODUCTION

1st 24 hrs. Nat. _____

1st 24 hrs. after shot _____

Gas _____ Cu. Ft.

Dry Hole _____

Abandoned _____

Date

NOV 13 1940 19

S. J. LEWIS Scout

Map No. 55 Sec. 9 Twp. 16 R. 10W

Well No. 2 Skalicky

Prunty Company

/ Contractor

COMPLETED
C E L NW NW

SECTION PLAT

660 Ft. from N. Line

 Ft. from S. Line

 Ft. from E. Line

990 Ft. from W. Line

STOLTENBERG POOL

o			

Location

Rig up

Drilling and Remarks:

Cr 83275-

6" @ 3276

Depth 7904

1 May 3000

44" Gr.

RECORD

Cased in., ft.

Sand

Gas

Oil

Total Depth 8289

PRODUCTION

1st 24 hrs. Nat.

1st 24 hrs. after shot

Gas Cu. Ft.

Dry Hole

Abandoned

Date

JAN 15 1941 19

G. I. LEWIS

Scout