


Ellsworth **KANSAS**

FORM 51 5M 10-41 PETROL

Section 9 Township 16 Range 10-W

Well No. #4 Skalicky

Company Magnolia

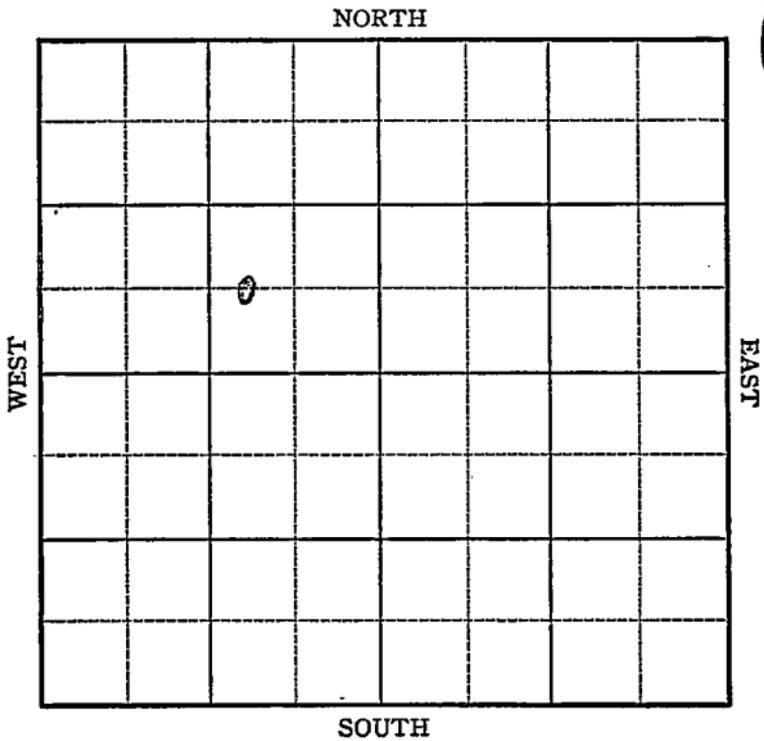

Sec. 9 Twp. 16 R. 10-W

Well No. #4 Skalicky Farm

Magnolia Company

(Stoltenberg)


_____ Ft. from N. Line

660 Ft. from S. Line

990 Ft. from E. Line

_____ Ft. from W. Line

Elev. 1829

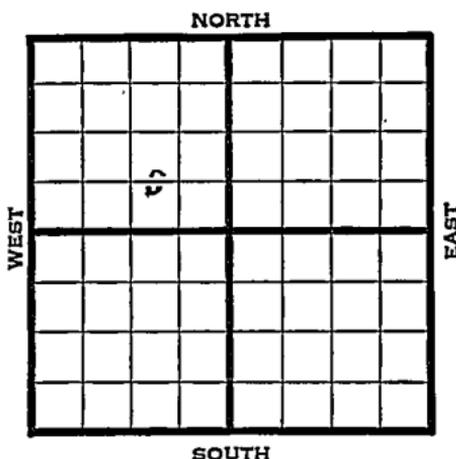

1941	REPORT
11/19	10" - 298' WOC.
11/26	Drlg. 1875'
12/4	Drlg. 3255'
12/11	Art. 3293
	5" @ 3294
	TD 3301-3100' oil
	2000' acid
12/17	Arb. 3293
	5" @ 3294
	2000 acid
	Depth 37246
	Maximum: 3000
	TD 3301
	Grav. 44
	COMPLETED

Map No. K-5-5 Sec. 9 Twp. 16 R. 10W

Well No. 4 Skalicky

Magnolia Company

FIRST REPORT Contractor

C WL SE NW

SECTION PLAT

_____ Ft. from N. Line

660 Ft. from S. Line

990 Ft. from E. Line

_____ Ft. from W. Line

	o		

STOLTENBERG POOL

Location _____

Rig up _____

Drilling and Remarks:

10" - 298!

Waiting on

Cement to set

RECORD

Cased _____ in., _____ ft.

Sand _____

Gas _____

Oil _____

Total Depth _____

PRODUCTION

1st 24 hrs. Nat. _____

1st 24 hrs. after shot _____

Gas _____ Cu. Ft.

Dry Hole _____

Abandoned _____

Date

NOV 19 1941

S. J. LEWIS Scout

Eli sworth

KANSAS

Map No. 55 Sec. 9 Twp. 16 R. 10WWell No. 4 SkalickyMagnolia CompanyCOMPLETED Contractor

C WL SE NW

SECTION PLAT

	0		

_____ Ft. from N. Line

660 Ft. from S. Line990 Ft. from E. Line

_____ Ft. from W. Line

STOLTENBERG POOL

Location _____

Rig up _____

Drilling and Remarks:

Cor Y 3293
5" @ 3294
2000 acid
Depth 37246
Map 3000
4496

RECORD

Cased _____ in., _____ ft.

Sand _____

Gas _____

Oil _____

Total Depth 3701

PRODUCTION

1st 24 hrs. Nat. _____

1st 24 hrs. after shot _____

Gas _____ Cu. Ft.

Dry Hole _____

Abandoned _____

Date

DEC 17 1941

19

S. J. LEWIS Scout