


Section 10 Township 16 Range 10W

Well No. #1 Funk

Company K & E Drlg.

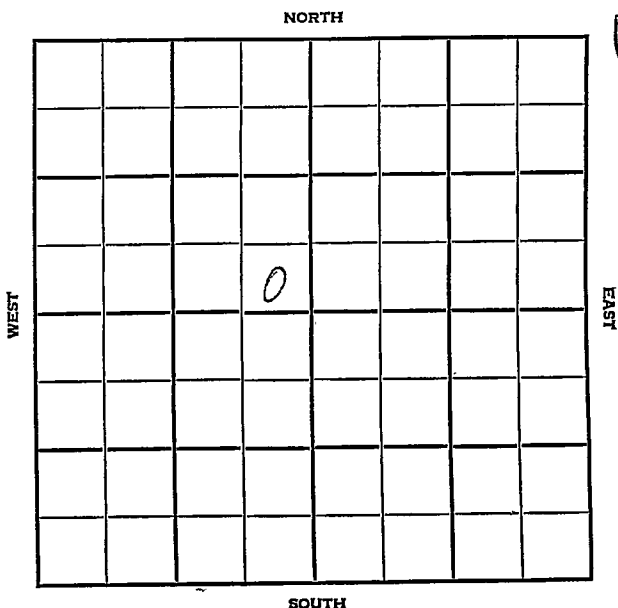

Ellsworth

KANSAS


SEC.	TWP.	R.
10	16	10W

WELL NO. _____

COMPANY #1 Funk FARM

CONTRACTOR K & E Drlg.

Co. Tools.

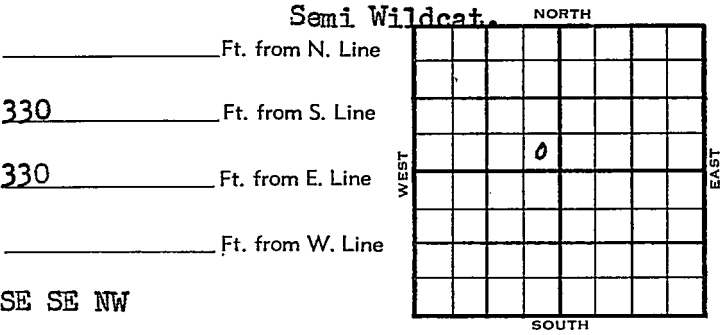

ELEVATION.	REPORT
1955 1869'	

3/23
4/27

Spud 3-22-55
 Spud 3-22-55
 Oil Well
 TD 3410
 8" @ 337'
 Annhy 660', Heeb 2899' Tor. 2919'
 Br. Lime. 3003', Lans. 3024'
 B KC 3292', Cong. 3311'
 DST 3369'-80' opn 1 hr, rec 8' Mud,
 840#
 Arb. 3402'
 DST 3373'-3405' opn 1 hr, rec 20' Mud,
 10845#
 DST 3403'-10' opn 1 hr, rec 2825' oil
 55' mo 1080#
 TD 3410
 5" @ 3404'
 CO to 3410'
 FU 2500' oil 1/2 hr. P/ 117 bo 5 hr.
 Comp BHB 3000 bopd.

COMPLETED

