


SECTION 10 TOWNSHIP 16 RANGE 10 W

WELL NO. #6 Funk

COMPANY K & E Drlg.

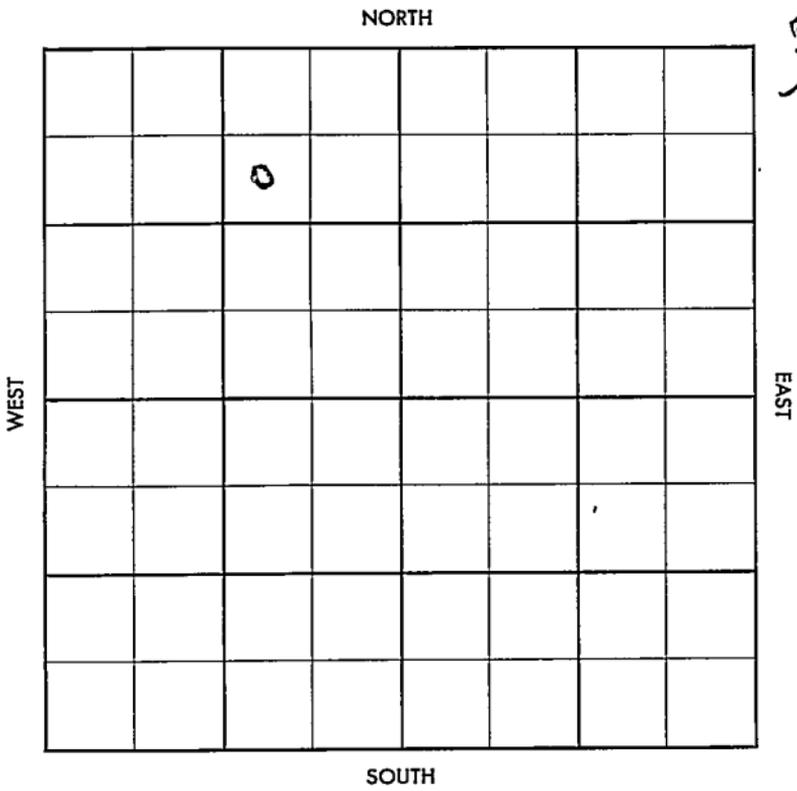


SEC.	TWP.	R.
10	16	10W

WELL NO. #6 Funk FARM

COMPANY K & E Drlg

CONTRACTOR Co Tools Progress

_____ Ft. from N. Line
 _____ Ft. from S. Line
 _____ Ft. from E. Line
 _____ Ft. from W. Line

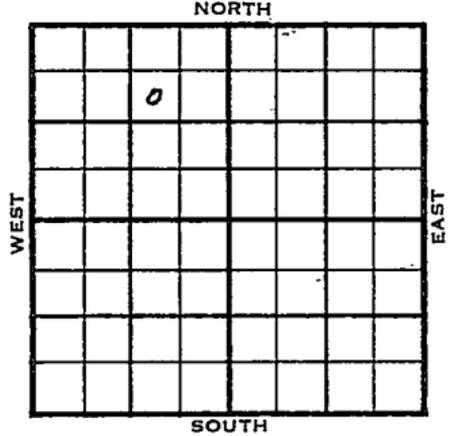

SW NE NW

	ELEVATION	REPORT
1955	1856'	
11/12	Comm 10-9-55 8" @ 354/175 H 2893 Tr 2911 Dg 2938 Drlg 3180	
11-30	DST 3408-12- op 1 hr. rec. 45' vsocmw, 1090#, DST 3412-17 op 1/2 hr. rec. 720' wtr. 1070#. 5 1/2" @ 3500 CO to 3800 Comp. SWD well BL. 2997' L. 3016' BKG. ### 3293 Shaley 3329 V. 3353 S. 3383 A. 3407 TD 3800'	ABANDONED

County Ellsworth Elev. _____
 Sec. 10 Twp. 16 Rge. 10W
 Company A & B Drlg.
 Farm Name Fuck No. 6

TOPS	DEPTH	LOG	DATUM
Anh.			
TP.			
H.	2893		
Tr.	2911		
Dg.	2938		
BL.			
L.			
K.C.			
B.K.C.			
Ce.			
C.			
M.			
M.			
K.			
Mz.			
Mq.			
V.			
S.			
S.			
A.			
R.			
PE.			
G.			
T.D.			

Loc. in Sec. SW NE NW

Geol. _____
 Contr. Co. tools

Pool Progress

FIRST REPORT

Date Comm. 11-9-55 ~~NOV 19 1955~~
8" @ 354/175 drlg. 3180 ~~NOV 16 1955~~

[Handwritten signature]

County Ellsworth Elev. 1856
 Sec. 10 Twp. 16 Rge. 10W
 Company K & E Drlg.
 Farm Name Funk No. 6

TOPS	DEPTH	LOG	DATUM	Loc. in Sec.
Anh.				SW NE NW
Tr.				
H.	2893		1037	
Tr.	2911		1055	
Dg.	2922		1066	
Bl.	2997		1141	
L.	3016		1160	
K.C.				Geol.
B.K.C.	3293		1437	Contr.
Ce.				Co. tools
C. <i>shaley</i>	3329		1473	
M.				Pool
M.				Progress
K.				
Mz.				
Mq.				
V.	3353		1497	
S.	3383		1527	
S.				
A.	3407		1551	
R.				
PE.				
G.				
T.D.	3800			

ABANDONED

Date Comm. 11-9-55 NOV 30 1955

8" @ 354/175 DST 3408-12 open 1 hr.

rec. 45' vsocmw 1090# DST 3412-17

open $\frac{1}{2}$ hr. rec. 720' wtr. 1070# $5\frac{1}{2}$ " @ 3500 CO to 3800 Comp. SWD well