
KANSAS Butler

FORM 51 5M PETROL

Section 2 Township 25 Range 5E

Well No. 21 Stone

Company Stelbar

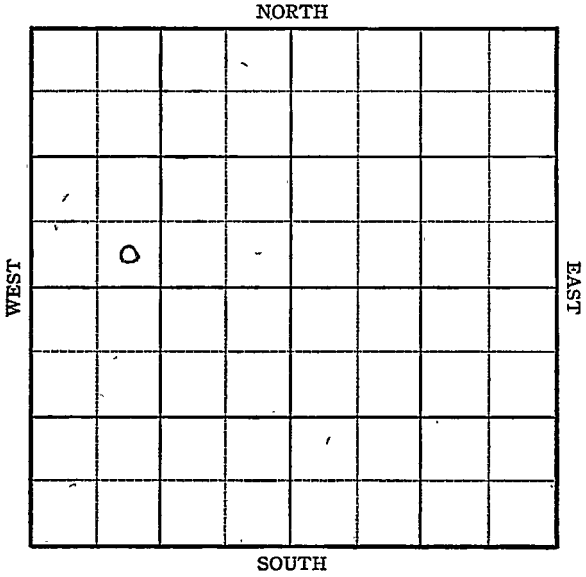

FORM 252-A
5M 8-45 PETROL

KANSAS Butler

Sec. 2 Twp. 25 R. 5-E

Well No. #21 Stone Farm


Stelbar Company

____ Ft. from N. Line

330 Ft. from S. Line

____ Ft. from E. Line

990 Ft. from W. Line

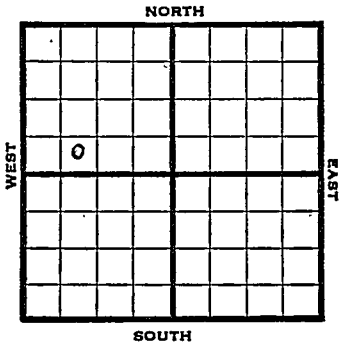

SE SW NW

1945	REPORT
9/12	10" @ 31' Penn 2166 T.D. 2168' Run csg.
9/19	7" @ 2168 TD 2210', RUST
9/26	Peru 2166 7" @ 2168 10 qts. 2195-2210 TD 2210' Pump 15 Pot. Grav. 39.0

COMPLETED

FORM 26 200 BKS 1-44 PETROL

KANSAS

Kansas Pool Name Miscellaneous

Map No. 14 Sec. 2 Twp. 25 R. 5E


Well No. 21 Stone

Stelbar Company

FIRST REPORT Contractor

SE SW NW

SECTION PLAT

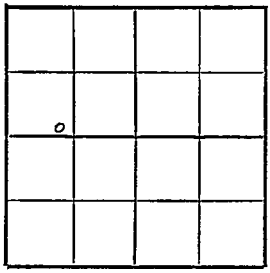

____ Ft. from N. Line

330 Ft. from S. Line

____ Ft. from E. Line

990 Ft. from W. Line

Butler County

Location

Rig up

Drilling and Remarks:

10" @ 31

Pern 2166

TD 2168

Run csg

RECORD

Cased ____ in., ____ ft.

Sand

Gas

Oil

Total Depth

PRODUCTION

1st 24 hrs. Nat.

1st 24 hrs. after shot

Gas ____ Cu. Ft.

Dry Hole

Abandoned

Date

SEP 1 2 1945 19

S. J. LEWIS Scout

FORM 26 200 BKS L-44 PETROL

KANSAS

Kansas Pool Name Miscellaneous

Map No. 14 Sec. 2 Twp. 25 R. 5E


Well No. 21 Stone

Stelbar Company

COMPLETED Contractor

SE SW NW

SECTION PLAT

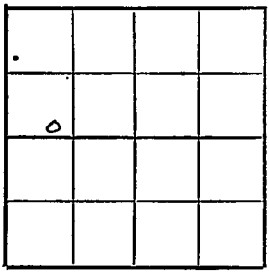

____ Ft. from N. Line

330 Ft. from S. Line

____ Ft. from E. Line

990 Ft. from W. Line

Butler County

Location

Rig up

Drilling and Remarks:

Perm 2166

7" @ 2168

10 to 2195-2210

Pump 15 BF

89° Gr

RECORD

Cased ____ in., ____ ft.

Sand

Gas

Oil

Total Depth 2210

PRODUCTION

1st 24 hrs. Nat.

1st 24 hrs. after shot

Gas ____ Cu. Ft.

Dry Hole

Abandoned

Date

SEP 2 6 1945 19 S. J. LEWIS Scout