

Section 3 Township 25 Range 5E
Well No. #1 Belton
Company Saco Oil

A 10x10 grid map. The top edge is labeled "NORTH", the bottom edge "SOUTH", the left edge "WEST", and the right edge "EAST". A small circle containing the letter "O" is located in the second row from the bottom and the eighth column from the left.

Butler

KANSAS ✓

Sec. 3 Twp. 25 R. 5E

Well No. #1 Belton Farm

Saco Oil Company

Contractor

Miscellaneous


Ft. from N. Line

990' Ft. from S. Line

330' Ft. from E. Line

Ft. from W. Line

NE SE SE

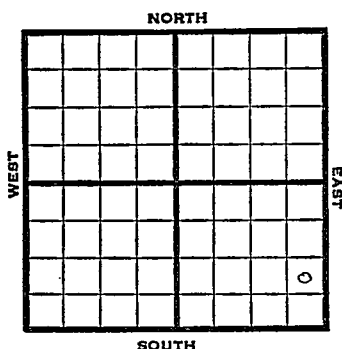

1950

Elev 1335' REPORT

3/15
5/3

Location

TD 2275'

15" @ 76'

13" @ 698'

10" @ 1600'

Lans 1695'

Pru Sd 2244-55'

7" @ 2235'

Shot with 6 qts 2244-60

25 BOPD

Comp

COMPLETED

Map No. _____ Sec. 3 Twp. 25 R. 5EWell No. 1 Belton

_____ Saco Oil _____ Company

_____ Contractor


NE SE SE

SECTION PLAT

_____ Ft. from N. Line

990 Ft. from S. Line330 Ft. from E. Line

_____ Ft. from W. Line

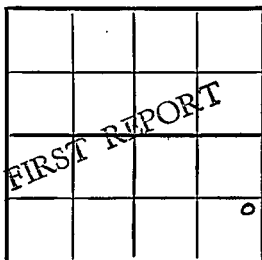Butler CountyLocation X

Rig up _____

Drilling and Remarks:

RECORD

Cased _____ in., _____ ft.

Sand _____

Gas _____

Oil _____

Total Depth _____

PRODUCTION

1st 24 hrs. Nat. _____

1st 24 hrs. after shot _____

Gas _____ Cu. Ft.

Dry Hole _____

Abandoned _____

Date

MAR 15 195019J. E. TYRA Scout

Kansas

Miscellaneous

Map No. _____ Sec. 3 Twp. 25 R. 5EWell No. 1 BeltonSaco Oil Company

Contractor


NE SE SE

E1. 1335
SECTION PLAT

_____ Ft. from N. Line

990 Ft. from S. Line330 Ft. from E. Line

_____ Ft. from W. Line

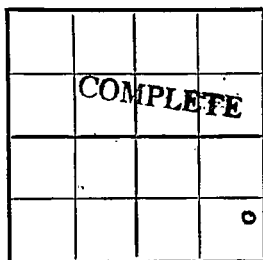

Butler County

Location _____

Rig up _____

Drilling and Remarks:

15" @ 7613" @ 69810" @ 1600Loss 1695Per sd 2244-557" @ 2235Shot with 6 gts/2244-60

Date

MAY 325 BOPD195019

RECORD

Cased _____ in., _____ ft.

Sand _____

Gas _____

Oil _____

Total Depth 2275

PRODUCTION

1st 24 hrs. Nat. _____

1st 24 hrs. after shot _____

Gas _____ Cu. Ft.

Dry Hole _____

Abandoned _____

J. E. TYRA

Scout