


Section 3 Township 25 Range 5E

Well No. #3 Belton

Company Saco Oil

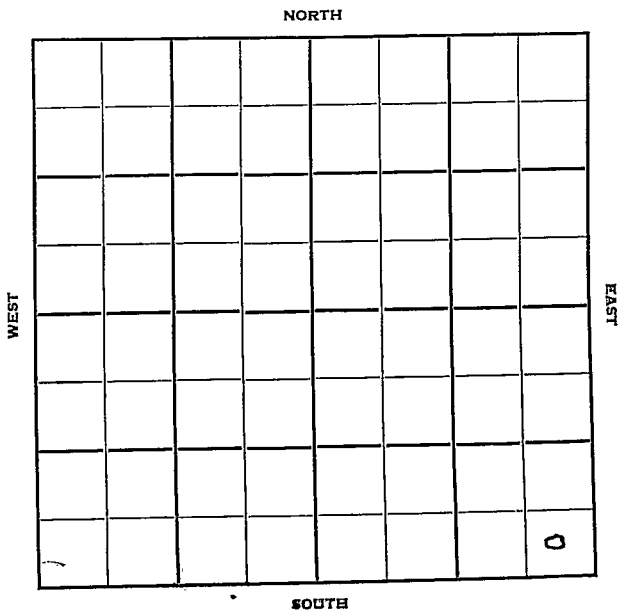

Sec. 3 Twp. 25 R. 5E

Well No. #3 Belton Farm

Saco Oil Company

Contractor

Ft. from N. Line

330


Ft. from S. Line

330

Ft. from E. Line

Ft. from W. Line

SE SE SE

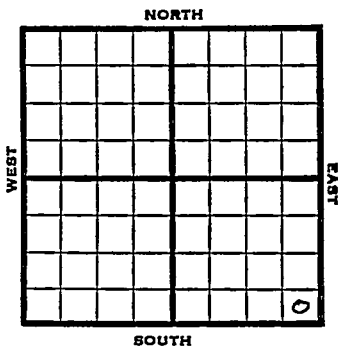

1952

Elev. 1330' REPORT

11/12

Spud 10-28-52
15" @ 140' 13" @ 741'
Drig. 1385'

12/3

Spud 10-28-52
Oil Well
TD 2251'
15" @ 140
13" @ 741
10" @ 1601
Lans 1702, KC 1978, Prue 2229',
7" @ 2229
DD 2251, Hydro.
Comp. 25 bopd

COMPLETED

