

KANSAS


FORM 51 5M 6-46 PETROL

Butler County

Section 2 Township 25c Range 5E

Well No. 15 Stone

Company Magnolia

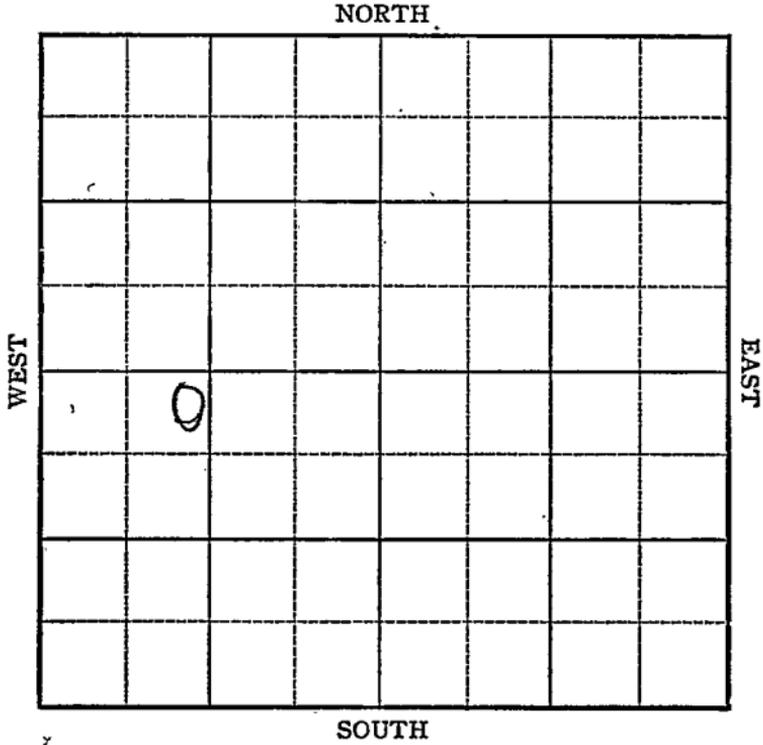



Sec. 2 Twp. 25 R. 5E

Well No. #15 Stone Farm
Magnolia Company

Miscellaneous


150 Ft. from N. Line

_____ Ft. from S. Line

1732 Ft. from E. Line

_____ Ft. from W. Line

NE NW SW

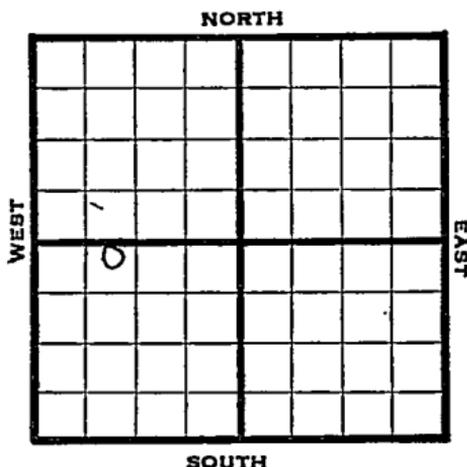

1946

Elev. 1338' REPORT

- 8/7 Location
- 8/13 "
- 8/20 "
- 8/27 "
- 9/5 "
- 9/10 "
- 9/18 "
- 9/24 "
- 10/1 "
- 10/8 "
- 10/15 16" @ 42'
Drlg 455'
- 10/22 13" @ 720'
Drlg 1035'
- 10/29 Drlg 1536'
- 11/6 Drlg 1910',
10" @ 1524'
- 11/12 " "
- 11/20 Viola 2404'
7" @ 2404'
TD 2405'
Pump 50 Pot
40 Grav.

COMPLETED

Kansas Pool Name Miscellaneous

Map No. KANSAS Sec. 2 Twp. 25 R. 5E

Well No. 15 Stone

Magnolia Company

FIRST REPORT

Contractor

NE NW SW

SECTION PLAT

150 Ft. from N. Line

_____ Ft. from S. Line

1732 Ft. from E. Line

_____ Ft. from W. Line

o			

Butler County

Location X

Rig up _____

Drilling and Remarks:

RECORD

Cased _____ in., _____ ft.

Sand _____

Gas _____

Oil _____

Total Depth _____

PRODUCTION

1st 24 hrs. Nat. _____

1st 24 hrs. after shot _____

Gas _____ Cu. Ft.

Dry Hole _____

Abandoned _____

Date

AUG 7 1946

19

S. J. LEWIS Scout

Form 26 200 Bks. 10-46 Petrol

Kansas

Map No. 14 Sec. 2 Twp. 25 R. 5E

Well No. 15 Stone

Magnolia Company

COMPLETED

Contractor

NE NW SW

EJ 1387
SECTION PLAT

150 Ft. from N. Line

 Ft. from S. Line

1732 Ft. from E. Line

 Ft. from W. Line

o			

Butler County

Location

Rig up

Drilling and Remarks:

Water 2404

7" @ 2404

Pump 50 ft

40° S

RECORD

Cased in., ft.

Sand

Gas

Oil

Total Depth 2405

PRODUCTION

1st 24 hrs. Nat.

1st 24 hrs. after shot

Gas Cu. Ft.

Dry Hole

Abandoned

Date

NOV 20 1946 19

S. J. LEWIS

Scout