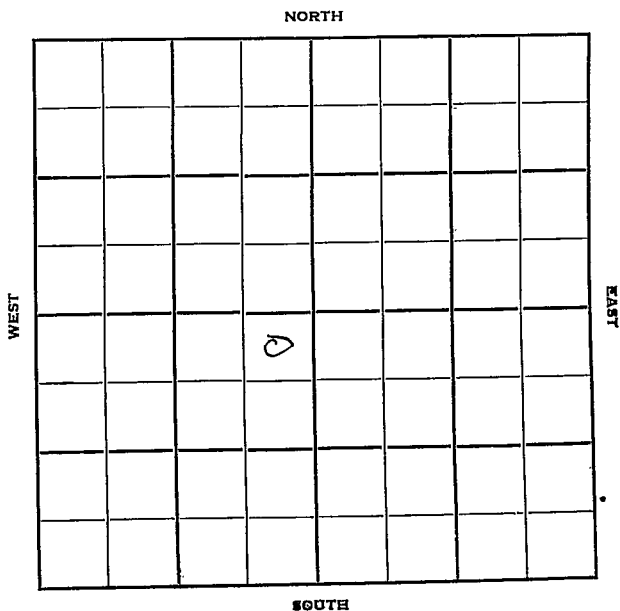


Section 2 Township 25 Range 5EWell No. #16 W. E. StoneCompany Magnolia

KANSAS

Butler

Sec. 2 Twp. 25 R. 5-E

Well No. #16 W E Stone Farm

Magnolia Company

B & R Drlg. Contractor

Miscellaneous


330 Ft. from N. Line

_____ Ft. from S. Line

330 Ft. from E. Line

_____ Ft. from W. Line

NE NE SW

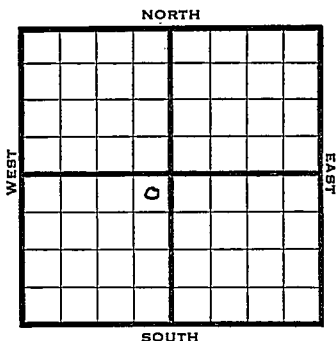

1950 Elev 1364 REPORT

8/30 Location

10/11 Spud 9-7-50

10" @ 105

Peru sand 2212-14

6" @ 2213

TD 2249

FU 150 gal water 1 pt oil 12 hr


DD 2258

70 qt 2218-54

FU 700' SW

D&A

ABANDONED

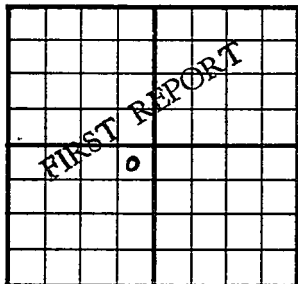County Butler State KansasSec. 2 (Blk. Twp.) 25 (Sur. Rge.) 5E Map No.Operator MagnoliaWell No. 16 Farm W. E. StoneElev. _____ Location NE NE SW330 Ft. From N Line SW330 Ft. From E Line Quarter1st. Report AUG 30 1950

Completion _____

Remarks _____

Spudding Date _____

Drlg. Data MiscellaneousLocation

J. E. TYRA

J. E. TYRA