


Butler

**KANSAS**

SECTION 3 TOWNSHIP 25 RANGE 5 E

WELL NO. #4 Belton

COMPANY Saco Oil

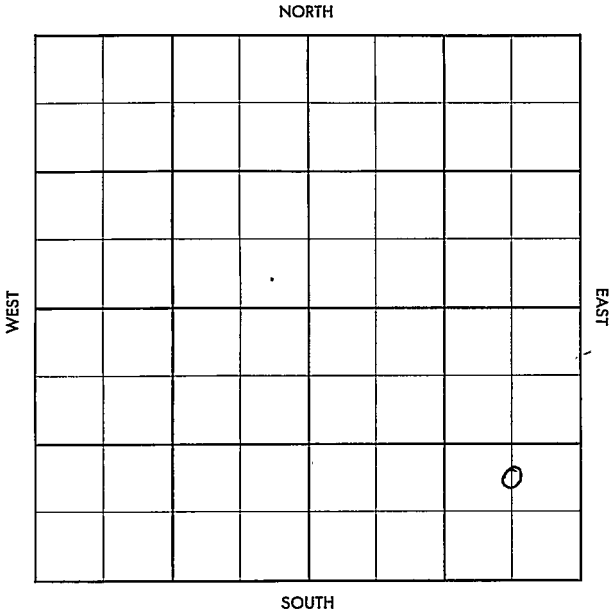

Butler KANSAS


SEC. 3	TWP. 25	R. 5E
-----------	------------	----------

WELL NO. #4 Belton FARM

COMPANY Saco Oil

CONTRACTOR Co. Tools

El Dorado  
 \_\_\_\_\_ Ft. from N. Line  
 1020 \_\_\_\_\_ Ft. from S. Line  
 915 \_\_\_\_\_ Ft. from E. Line  
 \_\_\_\_\_ Ft. from W. Line  
 C N  $\frac{1}{2}$  SE SE

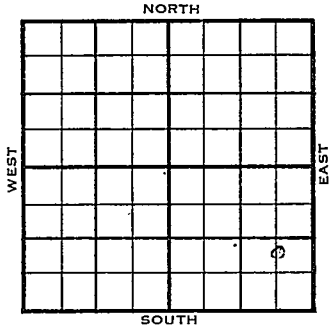

1955	ELEVATION 1346'	REPORT
------	--------------------	--------

12-7	RUCT	
------	------	--

1956		
------	--	--

1-5	Comm. 12-8-55 13 3/8" @ 187 10" @ 792 5 1/2" @ 2265 CO to 2269 12/ 2264-65, S/ 5 bopd, frac Comp. 15 bopd L. 1710 Peru 2250 TD 2269'	
-----	--	--

COMPLETED

County Butler Elev. \_\_\_\_\_  
 Sec. 3 Twp. 25 Rge. 5E  
 Company Saco Oil  
 Farm Name Belton No. 4

TOPS	DEPTH	LOG	DATUM
Anh.			
Tp.			
H.			
Tr.			
Dg.			
Bl.			
L.			
K.C.			
B.K.C.			
Ce.			
C.			
M.			
M.			
K.			
Mz.			
Mo.			
V.			
S.			
S.			
A.			
R.			
Pe.			
G.			
T.D.			

Loc. in Sec. \_\_\_\_\_  
C N<sup>1</sup>/<sub>2</sub> SE SE  
1020' SL  
915' EL  
 Geol. \_\_\_\_\_  
 Contr. \_\_\_\_\_  
Co. tools  
 Pool \_\_\_\_\_  
ElDorado

FIRST REPORT		DEC 7 '55	a

Date Comm. \_\_\_\_\_  
RUCT

Co. \_\_\_\_\_  
 Lse. \_\_\_\_\_  
 No. \_\_\_\_\_  
 Sec. \_\_\_\_\_  
 T. \_\_\_\_\_  
 R. \_\_\_\_\_

County Butler Elev. 1346  
 Sec. 3 Twp. 25 Rge. 5E  
 Company Saco Oil  
 Farm Name Belton No. 4

TOPS	DEPTH	LOG	DATUM	Loc. in Sec.	
Anh.				C N $\frac{1}{2}$ SE SE 1020' SL 915' EL	
Tr.	
Dg.	
Bl.	
L.	<u>1710</u>		<u>964</u>	Geol.	
K.C.				Contr.	
B.K.C. <u>P.O.M.</u>	<u>2250</u>		<u>904</u>	Co. tools	
Ce.				Pool	
C.				<u>El Dorado</u>	
M.				<table border="1"> <tr><td></td><td></td><td></td><td></td></tr> <tr><td></td><td></td><td></td><td></td></tr> <tr><td></td><td></td><td></td><td></td></tr> <tr><td></td><td></td><td></td><td></td></tr> <tr><td></td><td></td><td></td><td></td></tr> <tr><td></td><td></td><td></td><td></td></tr> <tr><td></td><td></td><td></td><td></td></tr> <tr><td></td><td></td><td></td><td></td></tr> <tr><td></td><td></td><td></td><td></td></tr> <tr><td></td><td></td><td></td><td></td></tr> </table>	
M.	
K.	
Mz.	
Ma.	
V.	
S.	
S.	
A.	
R.	
Pe.	
G.	
T.D.	<u>2269</u>	

Date Comm. 12-8-55 JAN 5 1956

13 3/8" @ 187 10" @ 792 5 1/2" @ 2265

CO. to 2269 12/ 2264-65 S/ 5 bopd

frac Comp. 15 bopd

\_\_\_\_\_  
 \_\_\_\_\_  
 \_\_\_\_\_  
 \_\_\_\_\_  
 \_\_\_\_\_  
 \_\_\_\_\_

Co.  
 Use.  
 No.  
 Sec.  
 T.  
 R.