

Ellsworth


Form 51-5M-2-29-34708

Map No. KANSAS Sec. 19 Twp. 16 R. 15^w

Well No. 5-2-19-16-15^w Farm

M. D. BUCK Company

NORTH

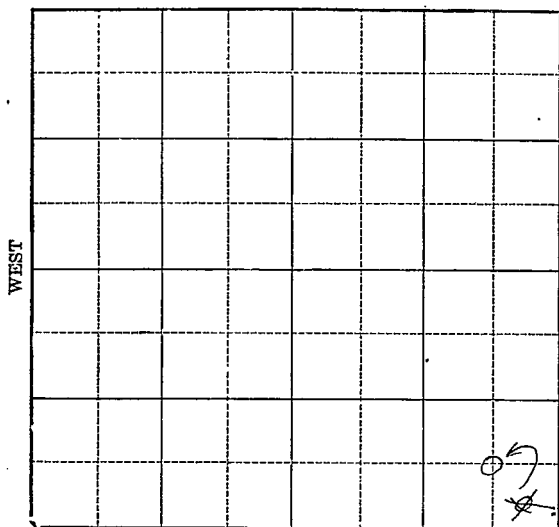

16

Location _____

Drilling Remarks _____

Rig Up _____

Drilling Remarks _____

RECORD

Cased _____ in. _____ ft.

Sand _____

Gas _____

Oil _____

Total Depth _____

PRODUCTION

1st 24 hrs. Nat. _____

1st 24 hrs. after shot _____

Gas _____ cu. ft.


Dry Hole _____

Abandoned _____

Map No. **KANSAS** Sec. 10 Twp. 16 R. 10^w

Well No. 1- Girik Farm
M. R. Buck Company

660 Ft. from N. Line
~~330~~ Ft. from S. Line
660 Ft. from E. Line
~~330~~ Ft. from W. Line
1931

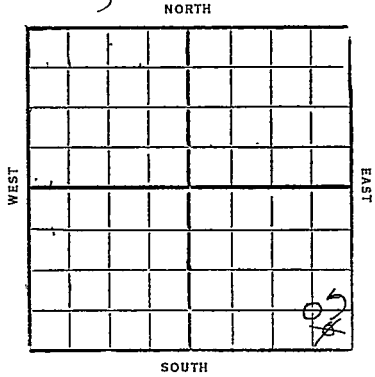

Date	REPORT	C 1805
10/21	Log	
10/28	Log	
11/4	Bldg rig	
11/10	Log	
11/18	Log	
11/24	Drilg 330'	
12/2	SIC 400'	
12/9		
12/16	6 failures water at 410	
	S/R 15" csg	
12/22	Drilg 735'	
12/30	S/R 12"-975'	
	Drilg 1100'	
1932		
1/7	" 1420'	
1/13	" 1765'	
1/20	SD 1970' for csg	
1/27	Drilg 2225'	
2/3	S/R 10"-2225'	
2/10	SD 2260'	
2/17		

2/26-	SD 2260'
3/2	—
3/9	—
3/16	—
3/22	—
3/30	—
4/6	—
4/13	—
4/20	—
4/27	—
5/4	—
5/11	—
5/18-	10"-2265
	T.D. 2280' Clg out
5/25	UIR 10"-2290'
6/1-	10"-2225
	Top K.C. lime 2545
	Dreg 2625
6/8-	show gas 2760
	Dreg 2910'
6/15-	8" 3090' SD
6/22	—
6/29	—
7/6	—
7/13	—
7/20	—
7/27	—
8/3	—
8/10	—
8/17	—
8/24	—
8/31	—

Ellsworth

55 KANSAS Sec. 10 Twp. 16 R. 10 W

Well No. 1 Jirik
M. R. Buck Company

Contractor

FIRST REPORTS

SECTION PLAT

.....Ft. from N. Line
330 Ft. from S. Line
330 Ft. from E. Line
.....Ft. from W. Line

			0

Location ✓
Rig up
Drilling and Remarks:

RECORD

Cased..... in., ft.
Sand.....
Gas.....
Oil.....
Total Depth.....

PRODUCTION

1st 24 hrs. Nat.....
1st 24 hrs. after shot.....
Gas..... Cu. Ft.
Dry Hole.....
Abandoned.....

Date

OCT 2 1 1931

CHAS. L. SHERWOOD

Ellsworth

Map No. 55 **KANSAS** Sec. 10 Twp. 16 R. 10 ^W

Well No. 1 *Jirid*

M. R. Buck Company

Contractor

CORRECTION

.....Ft. from N. Line

660 Ft. from S. Line

660 Ft. from E. Line

.....Ft. from W. Line

SECTION PLAT

			0

Location.....

Rig up.....

Drilling and Remarks:

Change Location

RECORD

Cased..... in.,ft.

Sand.....

Gas.....

Oil.....

Total Depth.....

PRODUCTION

1st 24 hrs. Nat.....

1st 24 hrs. after shot.....

Gas..... Cu. Ft.

Dry Hole.....

Abandoned.....

Date

OCT 28 1931

192 **CHAS. L. SHERWOOD** Scout

Ellsworth

55 KANSAS

W

Map No. _____ Sec. 10 Twp. 16 R. 10

Well No. 1

M. R. Buck Company

Contractor

COMPLETED

SECTION PLAT

_____ Ft. from N. Line

660 Ft. from S. Line

660 Ft. from E. Line

_____ Ft. from W. Line

ABANDONED

Location _____

Rig up _____

Drilling and Remarks:

Top Cong 3285
HF W 3380-84

RECORD

Cased _____ in., _____ ft.

Sand _____

Gas _____

Oil _____

Total Depth 3384

PRODUCTION

1st 24 hrs. Nat. _____

1st 24 hrs. after shot _____

Gas _____ Cu. Ft.

Dry Hole

Abandoned

Date

SEP 14 1932

CHAS. L. SHERWOOD

192

Scout