

Map No. KANSAS Sec. 15 Twp. 16 R. 10


Well No. 1 Orth Farm

Gypsy Oil Company

NORTH

WEST

EAST

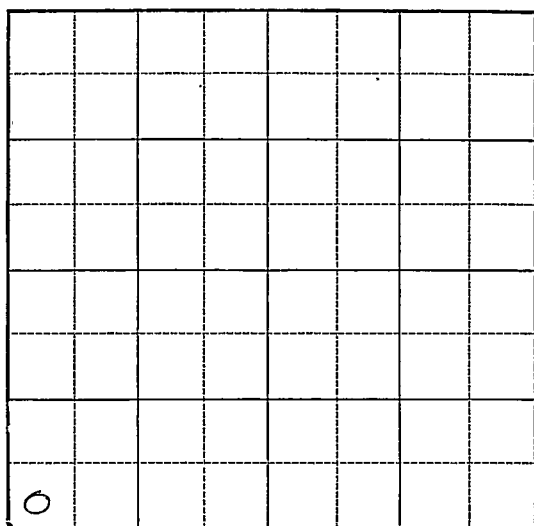

SOUTH

Location _____
Drilling Remarks _____

Rig Up _____
Drilling Remarks _____

RECORD
Cased _____ in. _____ ft.
Sand _____
Gas _____
Oil _____
Total Depth _____

PRODUCTION
1st 24 hrs. Nat. _____
1st 24 hrs. after shot _____
Gas _____ cu. ft.
Dry Hole _____
Abandoned _____

Ellsworth

Form 252-A
5M 4-32 MPC

Map No. KANSAS Sec. 15 Twp. 16 R. 10-W

Well No. 1- Orth Farm


Gypsy oil Company

 Ft. from N. Line

330 Ft. from S. Line

 Ft. from E. Line

330 Ft. from W. Line

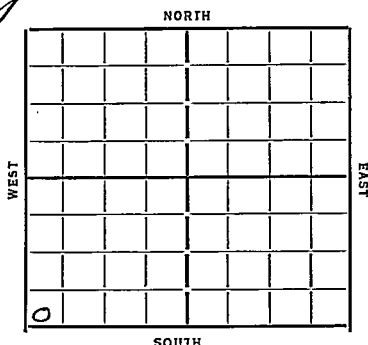

Date
1933

REPORT

6/14 Bldg rig
6/21 Regw up
6/28 20"-270' drlg 440'
7/5 Tsg logs
7/12 —
7/19 skid rig spud down
7/26 15"-570' drlg 1005'
8/2 12"-1070 drlg 1680'
8/9 10" 2005 " 2375'
8/16 show oil 2840-45' drlg 2950'
8/23 Cong. 3320' Siliceous 3357' show oil
run 6"
8/30 T.D. 3367-3200' oil
9/6 Swab 70 bbls per hr 2 hrs
9/13 —
9/20 Top Siliceous 3357
T. D. 3367 pump
2000 bbls oil
24 hours

COMPLETED

Ellsworth

Map No. _____ Sec. 15 Twp. 16 R. 10W

Well No. 1 - Orth

Gypsy Oil Company

Contractor

SW SW

SECTION PLAT

Ft. from N. Line

330 Ft. from S. Line

Ft. from E. Line

330 Ft. from W. Line

FIRST REPORTS

0

Location _____

Rig up _____

Drilling and Remarks:

Beag Rig

RECORD

Cased _____ in., _____ ft.

Sand _____

Gas _____

Oil _____

Total Depth _____

PRODUCTION

1st 24 hrs. Nat. _____

1st 24 hrs. after shot _____

Gas _____ Cu. Ft.

Dry Hole _____

Abandoned _____

Date

6/14/33 192 Cival Mammals

Map No. _____ Sec. 15 Twp. 16 R. 10W

Well No. 55 #1 - Orth

Kypsy Oil Company

Contractor

SECTION PLAT

_____ Ft. from N. Line

330 Ft. from S. Line

_____ Ft. from E. Line

330 Ft. from W. Line

COMPLETED

Location _____

Rig up _____

Drilling and Remarks:

RECORD

Cased _____ in., _____ ft.

Sand siliceous 3357

Gas _____

Oil _____

Total Depth 3367

PRODUCTION

1st 24 hrs. Nat. _____

1st 24 hrs. after shot _____

Gas _____ Cu. Ft.

Dry Hole _____

Abandoned _____

Pump
2000 bbls
24 hrs

Date

7/20/33 192 C. Mammichub Scout