


Section 34 Township 25 Range 4E

Well No. #1 McCullough

Company H.C. Bennett

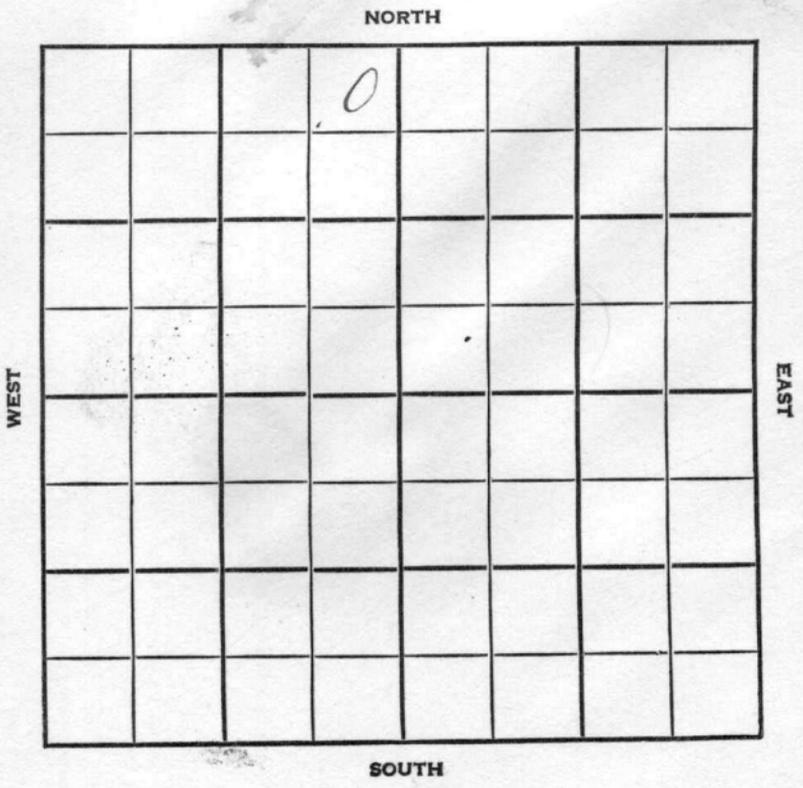

WILDCAT

FORM 513 SUNRAY

County Butler Elev. _____
 Sec. 34 Twp. 25 Rge. 4E
 Company H. C. Bennett
 Farm Name McCullough No. 1

TOPS	DEPTH	LOG	DATUM	Loc. in Sec.
Anh.				NE NE NW
TP.				
H.				
Tr.				
Dg.				
Bl.				
L.				Geol. _____
K.C.				Contr. _____
B.K.C.				
Ce.				
C.				
M.				Pool _____
M.				
K.				Wildcat
Mz.				
Me.				
V.				
S.				
S.				
A.				
R.				
PE.				
G.				
T.D.				

Date Comm. 11-25-56 C. S. O. DHM
8" @ 107, drlg. 700

~~29~~

Co.

Sec.

No.

Sec.

T.

R.

County Butler Elevation 1307
 Sec. 34 Twp. 25 Rge. 4E
 Company H. C. Bennett
 Farm Name McCullough No. 1

TOPS	DEPTH	LOG	DATUM	Loc. in Sec.
Anh.				NE NE NW
Tp.				
H.				
Tr.				
Dg.				
Bl.				
L.				
K.C.	2026			Geol.
B.K.C.	2184			Contr.
Ce.				
C.	2438			
M.	LI 2503			
M.				Pool
K.				Wildcat
Mz.				
Me.				
V.				
S.	erro 2570			<div style="border: 1px dashed black; padding: 5px; text-align: center;"> 0 ABANDONED DEC 13 '56 </div>
S.				
A.	2592			
R.				
Pe.				
G.				
TD.	2612			

Date Comm. 11-25-56 C. S. O. DHM
8" @ 107, drlg. 700 DEC 5 '56 DST
2504-08 45" rec 20' MEW
FP 0-30 BHP 810/20 DST
2517-38 30" 1635' SW
BHP 900/20 @ 2575 DEC 12 '56
DST 2595-2612 up 15" NW
2210' SW BHP 980

D&A