

Section 35 Township 25 Range 4E

Well No. 2 Frazier-Girod

Company Franco Central

NORTH

								0	

WEST

EAST

SOUTH

Butler
25

KANSAS ✓
4E

Sec. 35 Twp. R.

Well No. #2 Frazier-Girod Farm

Franco Central Company

White & Ellis Contractor


Ft. from N. Line

440 Ft. from S. Line

440 Ft. from E. Line

Ft. from W. Line

NORTH

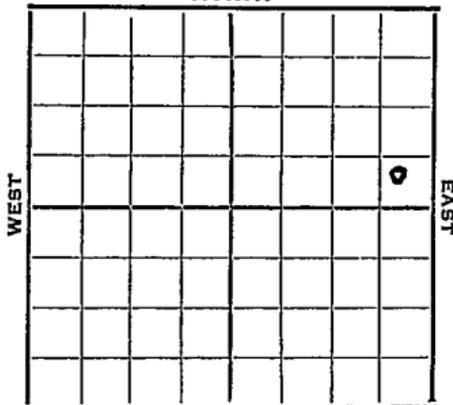

SOUTH

SE SE NE

1952 Elev. 1373' REPORT

12/23 RUR

1953
3/4

Spud 12-21-52
 Oil Well
 TD 2470
 8" @ 98
 KC 1975, B KC 2147, Arb 2406,
 TD 2410
 5" @ 2408
 CO to 2410
 DD 2428 S/2 boph 10 bopd
 500A
 S/4 bo 36 bwph
 DD 2459
 FU 500' fluid
 S/1 bo 3 bwph
 DD 2470 2 bfph
 Comp. 5 bopd 35 bw

COMPLETED

